


**REGISTERED SURVEYOR'S CERTIFICATION**  
 LandPartners Pty Ltd hereby certify that the vertical and horizontal locations and dimensions shown on this plan are a true and correct record and were located by survey.  
*Ross McDowall* (Director)  
 LandPartners Pty Ltd, Reg. Surveyor No. S4118 Date: 10/02/2020

**ENGINEER'S CERTIFICATION**  
 I, \_\_\_\_\_, hereby certify that:  
 1. The information contained in this drawing / document is in compliance with approved drawings and design.  
 2. The new water and sewerage works defined by this drawing have been designed and constructed in accordance with the SEQ Code.  
 3. This represents an accurate record of as-constructed works.  
 4. I accept responsibility for the information contained in this drawing / document.  
 RPEQ (signature) RPEQ No. \_\_\_\_\_ Date: \_\_\_\_\_

**AS CONSTRUCTED**

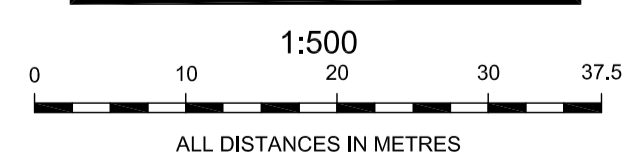

|           |       |            |               |       |         |        |
|-----------|-------|------------|---------------|-------|---------|--------|
| <b>A1</b> | 1     | 10/02/2020 | INITIAL ISSUE | VO    | RA      | RA     |
|           | INDEX | DATE       | REVISIONS     | DRAWN | CHECKED | PASSED |

|          |      |            |
|----------|------|------------|
| DRAWN    | VO   | 10/02/2020 |
| CHECKED  | RA   | 10/02/2020 |
| PASSED   | RA   | 10/02/2020 |
| INITIALS | DATE |            |



**Queensland Urban Utilities**  
 236-240 MONTEREA ROAD, RIPLEY - PRECINCT 2 - STAGE 1  
 AS CONSTRUCTED SEWER

SCALE 1:500  
 SHEET 1 OF 1 SHEETS  
 DRAWING NO.  
 BRSS6904-001-33-1