

LEGEND

| | |
|--|----------------|
| | BOTTOM OF WALL |
| | TOP OF WALL |
| | BACK OF KERB |
| | BOTTOM OF BANK |
| | TOP OF BANK |

Works As Constructed

It is certified that the locations, Levels and dimensions of the infrastructure shown herein are a true representation of the constructed works and that the As-Constructed survey was performed to the prescribed accuracy standards.

Authorised Delegate... *Rosa McDowall* (Director).....

Date..... 11/02/2020.....

LandPartners Pty Ltd (ACN 118 146 008) Surveyor No. S4118


Works As Constructed

It is certified that works herein have been constructed to Local Government standards, relevant approved specifications and the operational works approval. The As-Constructed Drawings for these works constitutes a true and correct record of the works constructed and complies with the design intent.

Signature..... RPEQ No.....

Date of Practical Completion.....

Engineering Consultant.....

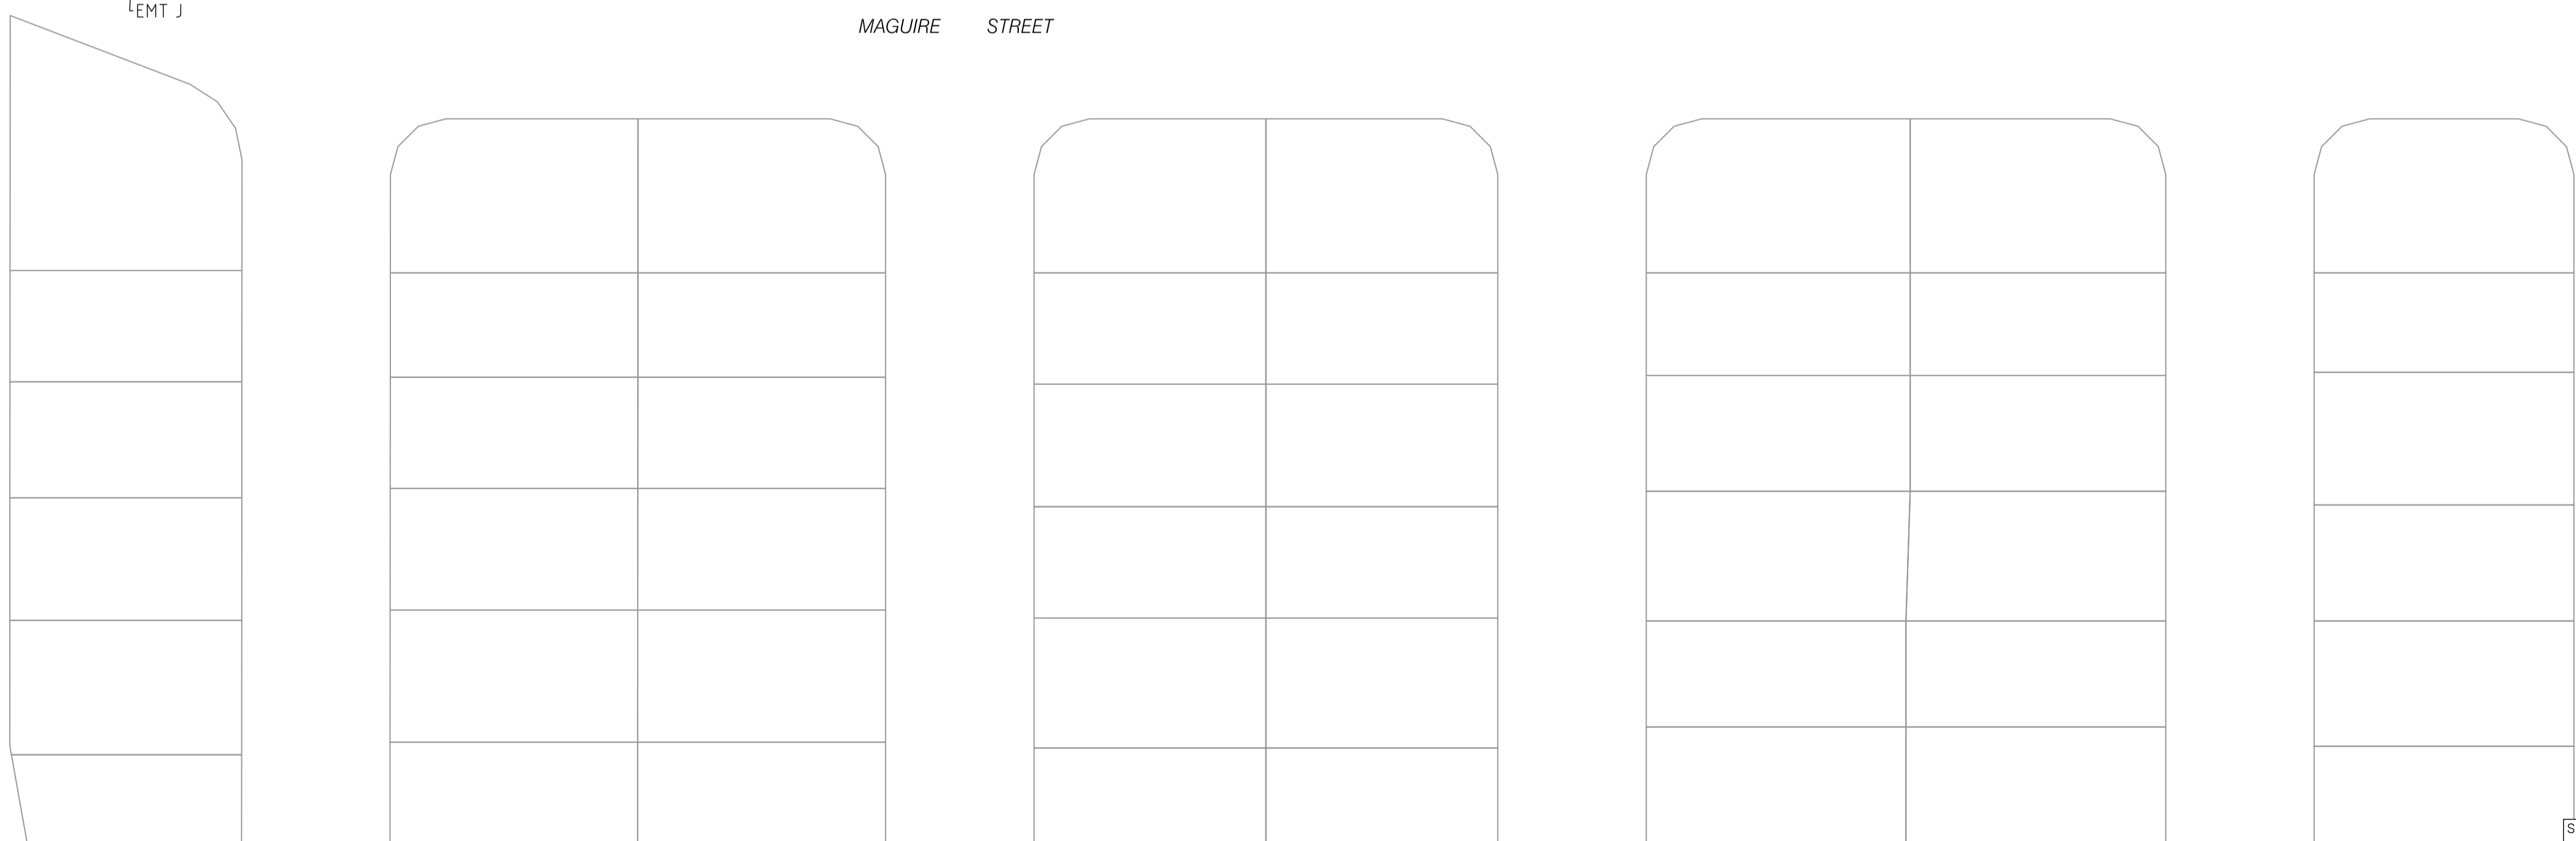

| | | | | | |
|----------|-----|--------------|-------------------|------|---------------------------|
| SHEET | | | 1 of 1 | | |
| DATUM | AHD | LEVEL ORIGIN | CONTOURS | 0.5m | FILE NO BRSS6904-001-35-1 |
| DRAWN | VO | DATE | CHECKED | RA | DATE |
| APPROVED | RA | DATE | PLAN NUMBER | | |
| | | | BRSS6904-001-36-1 | | |

A1

| ISSUE | DATE | AUTHOR | COMMENTS | ISSUE | DATE | AUTHOR | COMMENTS |
|-------|------------|--------|---------------|-------|------|--------|----------|
| 1 | 11/02/2020 | VO | INITIAL ISSUE | | | | |
| | | | | | | | |
| | | | | | | | |



Brisbane Office
 Level 1,
 28 Leslie Crabb Street,
 Milton, QLD, 4064
 PO Box 13999
 1 (07) 3842 1000
 e info@landpartners.com.au
 w www.landpartners.com.au

CLIENT
MONTEREA LAND HOLDINGS PTY LTD

PROJECT
**AS CONSTRUCTED TOPOGRAPHY
 236-240 MONTEREA ROAD, RIPLEY
 PRECINCT 2 - STAGE 1**

ENGINEERING CONSULTANT
BORNHORST + WARD

LG/SERVICE PROVIDER
IPSWICH CITY COUNCIL

