

**LEGEND**

- (RT) READY TAP/(TB) TAPPING BAND
- (WM) WATER METER (SEQ 20φ)
- TEE
- EXISTING WATER

**REGISTERED SURVEYOR'S CERTIFICATION**

..... LandPartners Pty Ltd ..... hereby certify that the vertical and horizontal locations and dimensions shown on this plan are a true and correct record and were located by survey.


*Ross McDowall* (Director)  
LandPartners Pty Ltd, Reg. Surveyor No. S4118 Date: 10/02/2020

**ENGINEER'S CERTIFICATION**

- I, ....., hereby certify that:
1. The information contained in this drawing / document is in compliance with approved drawings and design.
  2. The new water and sewerage works defined by this drawing have been designed and constructed in accordance with the SEQ Code.
  3. This represents an accurate record of as-constructed works.
  4. I accept responsibility for the information contained in this drawing / document.

RPEQ (signature) RPEQ No. \_\_\_\_\_ Date: .....

**AS CONSTRUCTED**

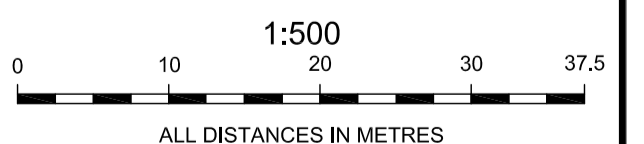

**A1**

INDEX	DATE	REVISIONS	DRAWN	CHECKED	PASSED
1	10/02/2020	INITIAL ISSUE	VO	RA	RA

DRAWN	VO	07/02/2020
CHECKED	RA	10/02/2020
PASSED	RA	10/02/2020
INITIALS	DATE	



**Queensland Urban Utilities**

236-240 MONTEREA ROAD, RIPLEY - PRECINCT 2 - STAGE 1  
AS CONSTRUCTED WATER

SCALE 1:500

SHEET 1 OF 1 SHEETS

DRAWING NO.

BRSS6904-001-34-1