


**REGISTERED SURVEYOR'S CERTIFICATION**  
 LandPartners Pty Ltd hereby certify that the vertical and horizontal locations and dimensions shown on this plan are a true and correct record and were located by survey.  
 Ross McDowall (Director)  
 LandPartners Pty Ltd, Reg. Surveyor No. S4118 Date: 17/08/2021

**ENGINEER'S CERTIFICATION**  
 I, Nicholas Rozis, hereby certify that:  
 1. The information contained in this drawing / document is in compliance with approved drawings and design.  
 2. The new water and sewerage works defined by this drawing have been designed and constructed in accordance with the SEQ Code.  
 3. This represents an accurate record of as-constructed works.  
 4. I accept responsibility for the information contained in this drawing / document.  
 RPEQ (signature) RPEQ No. 7729 Date: 23/08/2021

AS CONSTRUCTED

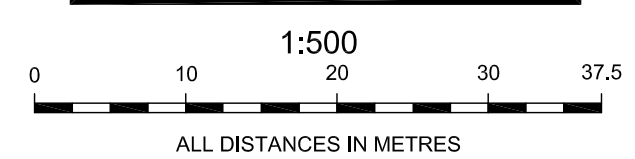



A1	1	17/08/2021	INITIAL ISSUE	VO	RA	RA
	INDEX	DATE	REVISIONS	DRAWN	CHECKED	PASSED

DRAWN	VO	17/08/2021
CHECKED	RA	17/08/2021
PASSED	RA	17/08/2021
INITIALS	DATE	



Queensland Urban Utilities  
 236-240 MONTEREA RD PRECINCT 2 - STAGE 3  
 AS CONSTRUCTED SEWER

SCALE 1:500  
 SHEET 1 OF 1 SHEETS  
 DRAWING NO.  
 BRSS6904-003-35-1

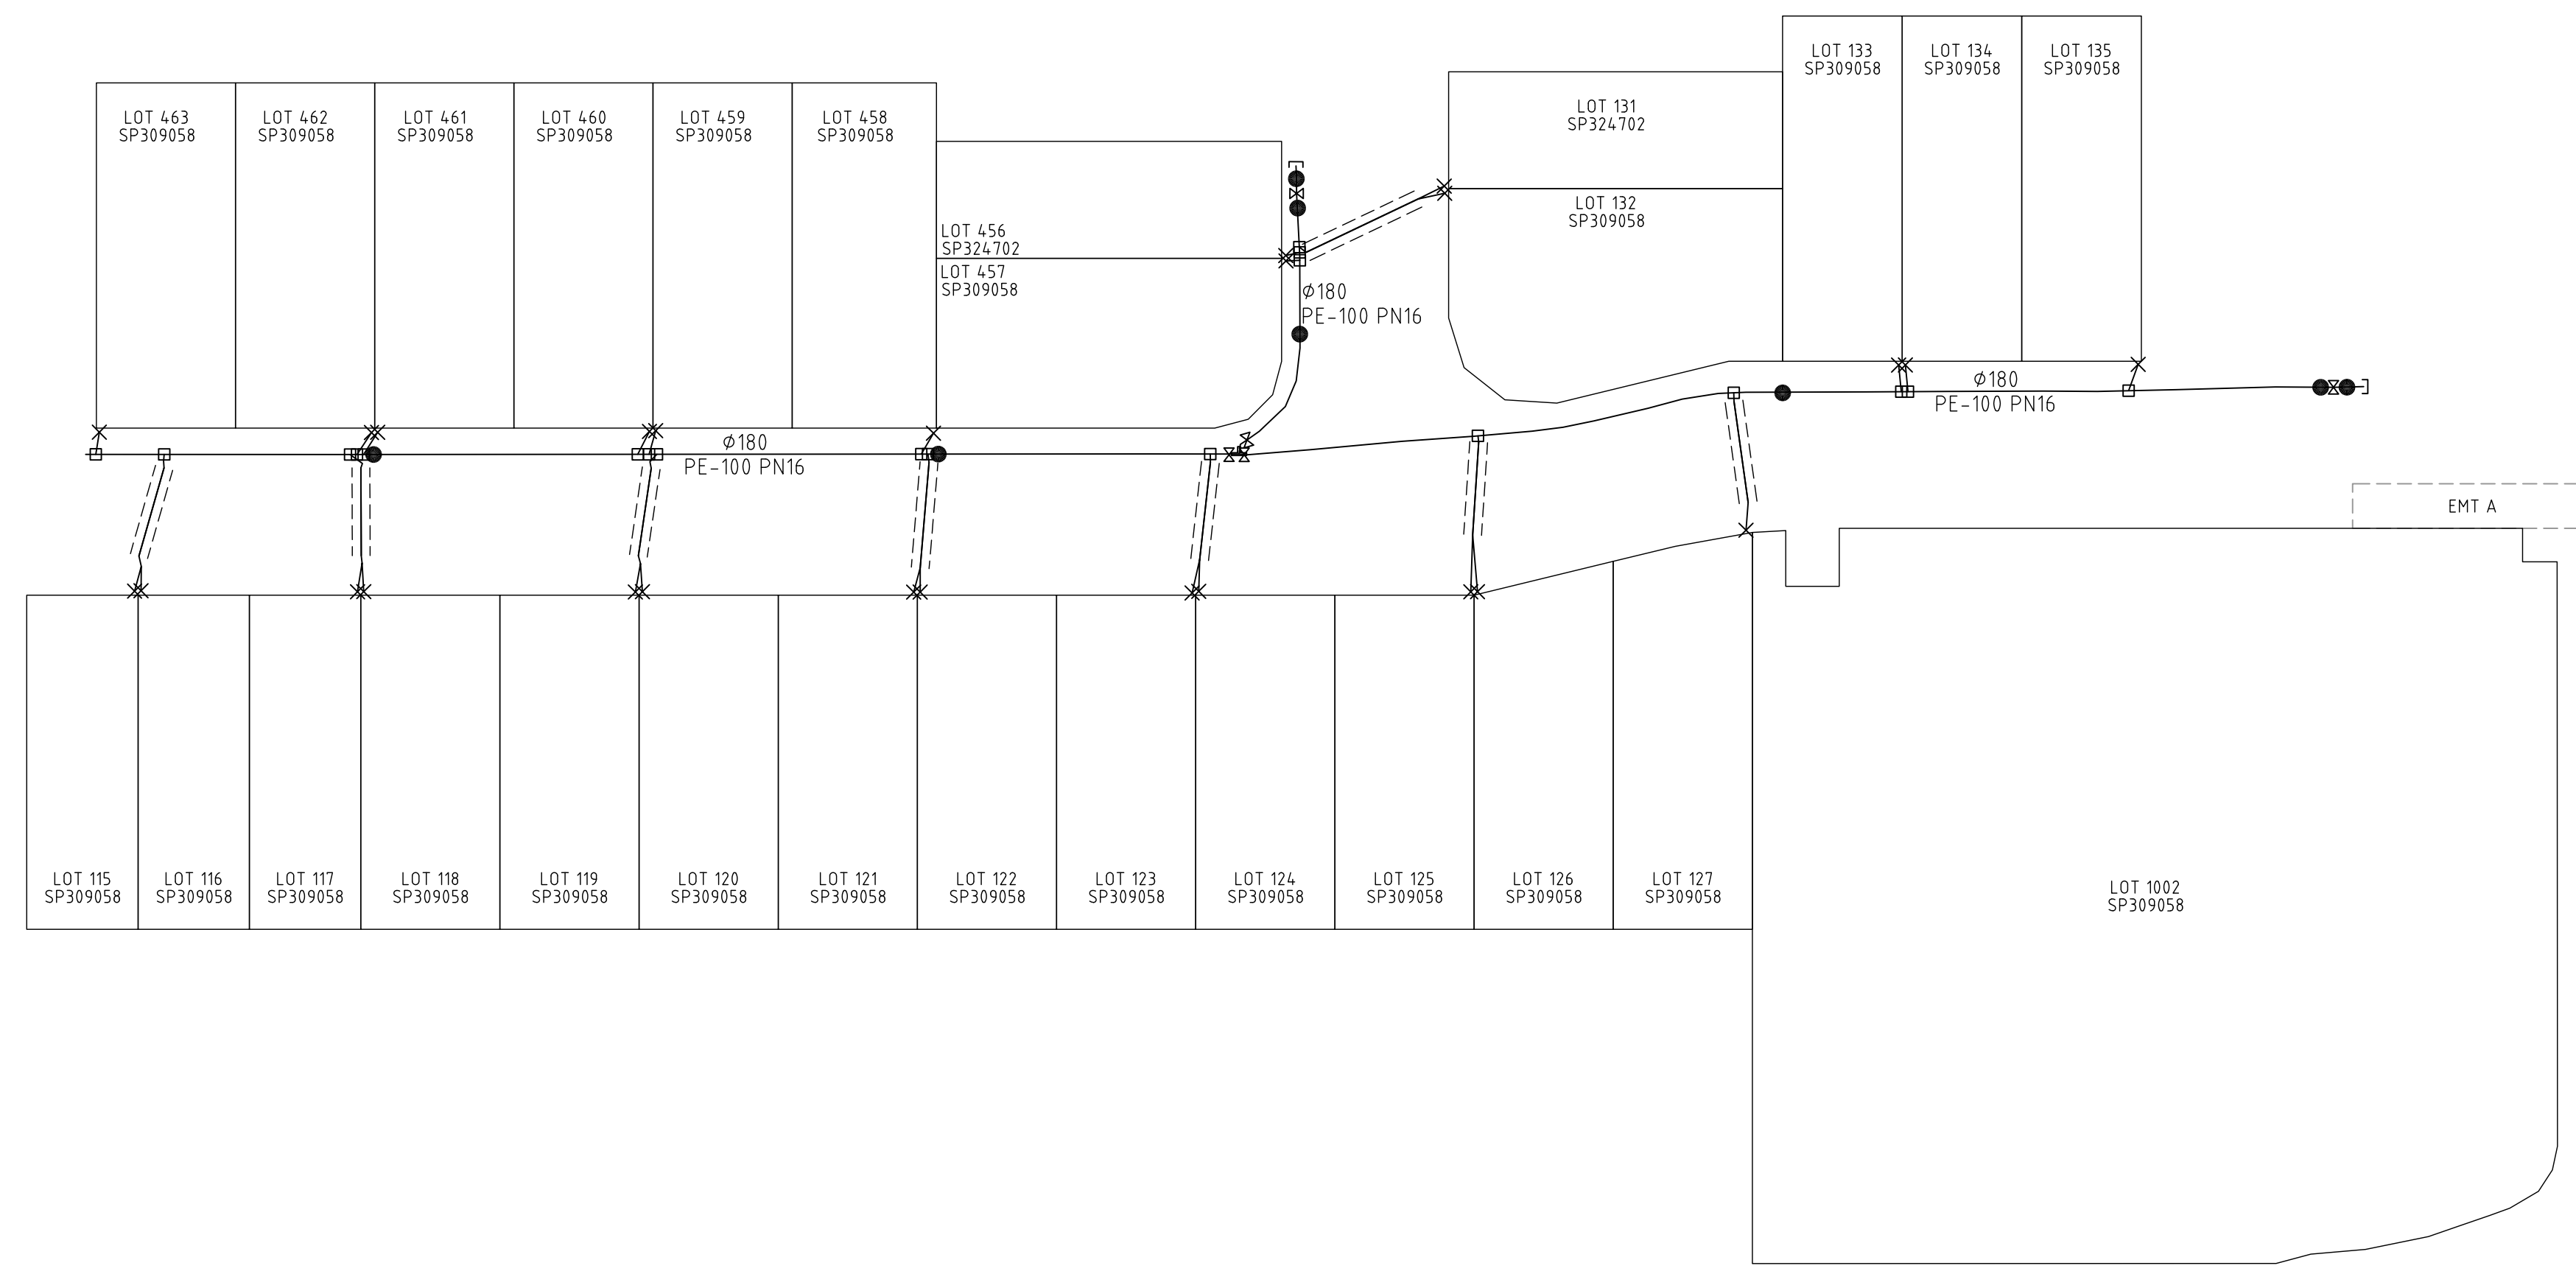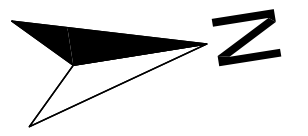


**LEGEND**

●	FIRE HYDRANT
⊗	STOP VALVE
⊠	TAPPING BAND
⊞	WATER METER (SEQ I(U) 204)
⊞	END CAP
⊞	TEE
⊞	REDUCER
⊞	BEND
—	WATER MAIN

**REGISTERED SURVEYOR'S CERTIFICATION**  
 LandPartners Pty Ltd hereby certify that the vertical and horizontal locations and dimensions shown on this plan are a true and correct record and were located by survey.  
 Ross McDowall (Director)  
 LandPartners Pty Ltd, Reg. Surveyor No. S4118 Date: 17/08/2021

**ENGINEER'S CERTIFICATION**  
 I, Nicholas Rozis, hereby certify that:  
 1. The information contained in this drawing / document is in compliance with approved drawings and design.  
 2. The new water and sewerage works defined by this drawing have been designed and constructed in accordance with the SEQ Code.  
 3. This represents an accurate record of as-constructed works.  
 4. I accept responsibility for the information contained in this drawing / document.  
 RPEQ (signature) RPEQ No. 7729 Date: 23/08/2021

**AS CONSTRUCTED**

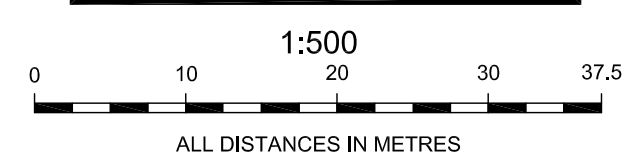

<b>A1</b>	1	17/08/2021	INITIAL ISSUE	VO	RA	RA
	INDEX	DATE	REVISIONS	DRAWN	CHECKED	PASSED

DRAWN	VO	17/08/2021
CHECKED	RA	17/08/2021
PASSED	RA	17/08/2021
INITIALS	DATE	



**Queensland Urban Utilities**  
 236-240 MONTEREA RD PRECINCT 2 - STAGE 3  
 AS CONSTRUCTED WATER

SCALE	1:500
SHEET 1	OF 1 SHEETS
DRAWING NO.	BRSS6904-003-36-1