

**A1**

ISSUE	DATE	AUTHOR	COMMENTS	ISSUE	DATE	AUTHOR	COMMENTS
1	16/07/2021	VO	PROGRESSIVE ISSUE				




Brisbane Office  
 Level 1,  
 18 Little Crabb Street,  
 Milton, QLD, 4064  
 PO Box 1399  
 t (07) 3842 1000  
 e info@landpartners.com.au  
 w www.landpartners.com.au

CLIENT  
**MONTEREA LAND HOLDINGS PTY LTD**

PROJECT  
**236-240 MONTEREA RD PRECINCT 2  
 STAGE 3  
 AS CONSTRUCTED TOPOGRAPHY**

ENGINEERING CONSULTANT  
**BORNHORST + WARD**

LGA/SERVICE PROVIDER  
**IPSWICH CITY COUNCIL**

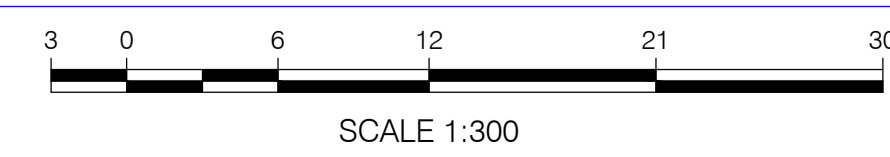

SHEET				<b>2 of 2</b>			
DATUM	AHD	LEVEL ORIGIN	PM	DRAWN	VO	DATE	16/07/2021
CONTOURS	N/A	FILE NO.	BRSS6904-002-33-6	CHECKED	RG	DATE	16/07/2021
APPROVED	RG	DATE	16/07/2021	PLAN NUMBER	<b>BRSS6904-002-39-1</b>		