

LEGEND

●	FIRE HYDRANT
⊠	STOP VALVE
⊞	TAPPING BAND
⊞	WATER METER (SEQ I(U)I 20#)
⊞	END CAP
⊞	TEE
⊞	REDUCER
⊞	BEND
—	WATER MAIN

REGISTERED SURVEYOR'S CERTIFICATION

LandPartners Pty Ltd hereby certify that the vertical and horizontal locations and dimensions shown on this plan are a true and correct record and were located by survey.

C. Walter (Authorised Delegate)
 LandPartners Pty Ltd, Reg. Surveyor No. S4118 Date: 01/07/2022


ENGINEER'S CERTIFICATION

I, _____ hereby certify that:

- The information contained in this drawing / document is in compliance with approved drawings and design.
- The new water and sewerage works defined by this drawing have been designed and constructed in accordance with the SEQ Code.
- This represents an accurate record of as-constructed works.
- I accept responsibility for the information contained in this drawing / document.

RPEQ (signature) _____ RPEQ No. _____ Date: _____

AS CONSTRUCTED

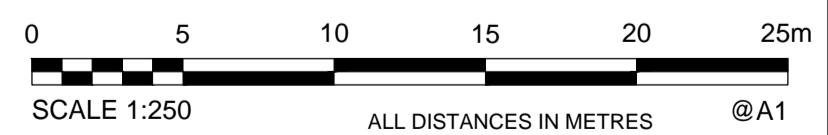

A1	1	01/07/2022	INITIAL ISSUE	VO	RA	RA
	INDEX	DATE	REVISIONS	DRAWN	CHECKED	PASSED

DRAWN	VO	01/07/2022
CHECKED	RA	01/07/2022
PASSED	RA	01/07/2022
INITIALS	DATE	



Queensland Urban Utilities

236-240 MONTEREA RD PRECINCT 2 - STAGE 4
 AS-CONSTRUCTED WATER

SCALE	1:250
SHEET 1	OF 1 SHEETS
DRAWING NO.	BRSS6904-004-64-1