


REGISTERED SURVEYOR'S CERTIFICATION
 LandPartners Pty Ltd hereby certify that the vertical and horizontal locations and dimensions shown on this plan are a true and correct record and were located by survey.
C. Walters (Authorised Delegate)
 LandPartners Pty Ltd, Reg. Surveyor No. S4118 Date: 01/07/2022

ENGINEER'S CERTIFICATION
 I, _____ hereby certify that:
 1. The information contained in this drawing / document is in compliance with approved drawings and design.
 2. The new water and sewerage works defined by this drawing have been designed and constructed in accordance with the SEQ Code.
 3. This represents an accurate record of as-constructed works.
 4. I accept responsibility for the information contained in this drawing / document.
 RPEQ (signature) RPEQ No. _____ Date: _____

AS CONSTRUCTED

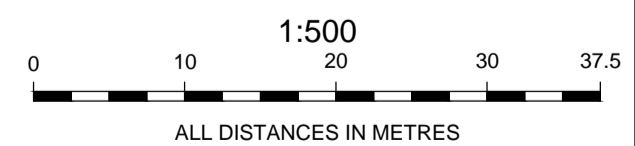

A1

| INDEX | DATE | REVISIONS | DRAWN | CHECKED | PASSED |
|-------|------------|---------------|-------|---------|--------|
| 1 | 01/07/2022 | INITIAL ISSUE | VO | RA | RA |

| DRAWN | VO | 01/07/22 |
|----------|------|----------|
| CHECKED | RA | 01/07/22 |
| PASSED | RA | 01/07/22 |
| INITIALS | DATE | |



Queensland Urban Utilities

236-240 MONTEREA ROAD
 PRECINCT 2 - STAGE 5A
 AS-CONSTRUCTED WATER

SCALE 1:500
 SHEET 1 OF 1 SHEETS
 DRAWING NO.
 BRSS6904-005-58-1