

**REGISTERED SURVEYOR'S CERTIFICATION**

I, LandPartners Pty Ltd, hereby certify that the vertical and horizontal locations and dimensions shown on this plan are a true and correct record and were located by survey.

Rosa McDowall (Director) LandPartners Pty Ltd (ACN 118 146 008)  
 Registered Surveyor (sig) Reg. Surveyor No. S4118 Date: 20/07/2022

**AS CONSTRUCTED CERTIFICATION**


I, \_\_\_\_\_ (Company's representative Name) \_\_\_\_\_ (Signature)  
 \_\_\_\_\_ (Date) \_\_\_\_\_ (RPEQ)  
 Being a duly representative of:- \_\_\_\_\_ (Company Name)

Hereby certify that:

- The information contained in this drawing / document is in compliance with approved drawings and design supplied under the terms of the contract.
- This represents an accurate "As constructed" record of works carried out and accept responsibility for the information contained in this drawing / document.

**COORDINATE DATUM NOTE:**  
 HORIZONTAL COORDINATES (E,N) SUPPLIED ARE MAPPING GRID OF AUSTRALIA (MGA), ZONE 56 BASED ON THE UNIVERSAL TRANSVERSE MERCATOR PROJECTION AND THE GEOCENTRIC DATUM OF AUSTRALIA 2020.

**AS CONSTRUCTED**

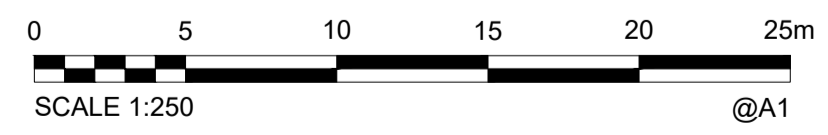

<b>A1</b>	1	20/07/2022	INITIAL ISSUE	VO	RA	RA
	INDEX	DATE	REVISIONS	DRAWN	CHECKED	PASSED

DRAWN	VO	20/07/22
CHECKED	RA	20/07/22
PASSED	RA	20/07/22
INITIALS	DATE	



**IPSWICH CITY COUNCIL**

236-240 MONTEREA RD PRECINCT 2 - STAGE 4  
 AS-CONSTRUCTED STORMWATER

SCALE 1:250  
 SHEET 1 OF 1 SHEETS  
 DRAWING NO.  
 BRSS6904-004-66-1