

**REGISTERED SURVEYOR'S CERTIFICATION**

I, LandPartners Pty Ltd, hereby certify that the vertical and horizontal locations and dimensions shown on this plan are a true and correct record and were located by survey.

Rose McDowall (Director) LandPartners Pty Ltd (ACN 118 146 008)  
Registered Surveyor (sig) Reg. Surveyor No. S4118 Date: 20/07/2022

**AS CONSTRUCTED CERTIFICATION**


I, \_\_\_\_\_ (Company's representative Name) \_\_\_\_\_ (Signature)  
\_\_\_\_ (Date) \_\_\_\_\_ (RPEQ)  
Being a duly representative of:- \_\_\_\_\_ (Company Name)

Hereby certify that:

- The information contained in this drawing / document is in compliance with approved drawings and design supplied under the terms of the contract.
- This represents an accurate "As constructed" record of works carried out and accept responsibility for the information contained in this drawing / document.

**COORDINATE DATUM NOTE:**  
HORIZONTAL COORDINATES (E,N) SUPPLIED ARE MAPPING GRID OF AUSTRALIA (MGA), ZONE 56 BASED ON THE UNIVERSAL TRANSVERSE MERCATOR PROJECTION AND THE GEOCENTRIC DATUM OF AUSTRALIA 2020.

**AS CONSTRUCTED**

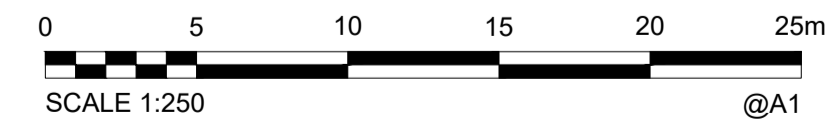

**A1**

| INDEX | DATE       | REVISIONS     | DRAWN | CHECKED | PASSED |
|-------|------------|---------------|-------|---------|--------|
| 1     | 20/07/2022 | INITIAL ISSUE | VO    | RA      | RA     |

| INITIALS   | DATE     |
|------------|----------|
| DRAWN VO   | 20/07/22 |
| CHECKED RA | 20/07/22 |
| PASSED RA  | 20/07/22 |



**IPSWICH CITY COUNCIL**

236-240 MONTEREA RD PRECINCT 2 - STAGE 5a  
AS-CONSTRUCTED STORMWATER

SCALE 1:250  
SHEET 1 OF 1 SHEETS  
DRAWING NO.  
BRSS6904-005-60-1