



LEGEND: NBN CONDUITS & PITS

- Fibre Access Node (FAN) site
- Fibre Distribution Hub (FDH) site - 1m x 1m
- Proposed 100mm Main Conduit
- Proposed 50mm Lateral Conduit
- Proposed 20mm Service Drop
- Proposed length of bored conduit
- Proposed shared trench
- Service Drop Access Pit
- Local Network Pit
- Premises Connection (Houses an MPT)
- Boundary Pit
- Cross-Road & Other Premises Connection (No MPT)
- Local Network Connection Pit
- Premises Connection & Fibre Splice Closure
- Distribution / Local Network Connection Pit at entry/exit to estate: @ 250m ccs on distribution conduit
- Fibre Distribution Hub (FDH) Pit Within 5m of FDH Site
- Multi Dwelling Unit (MDU)
- Transformer Pad Mount / Pole Mount
- Existing Telstra conduit trench layout (Proposed conduit indicated for comms cable)
- Existing NBN 100mm conduit
- Existing Telstra P100 conduit
- Existing or proposed Energex pole (& pole ID)
- Existing Telstra Exchange
- Existing Telstra Pits (size 2,3,4,5,6,7,8 or 9)
- Existing Telstra Manholes (Access Chambers)
- Existing Traffic Signals Box
- Existing network item to be removed/replaced
- 'C' communications marker plate

NO PITS IN THE SHADED AREA

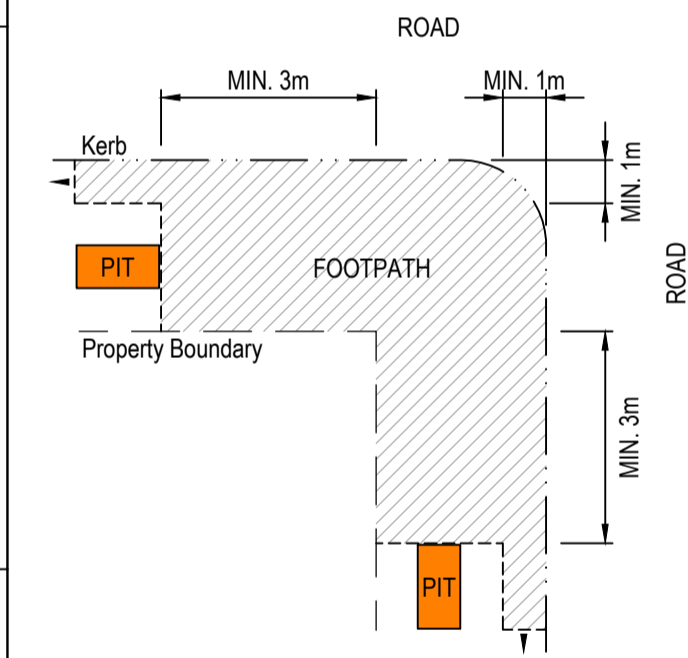


SHARED TRENCH DETAIL-NBN

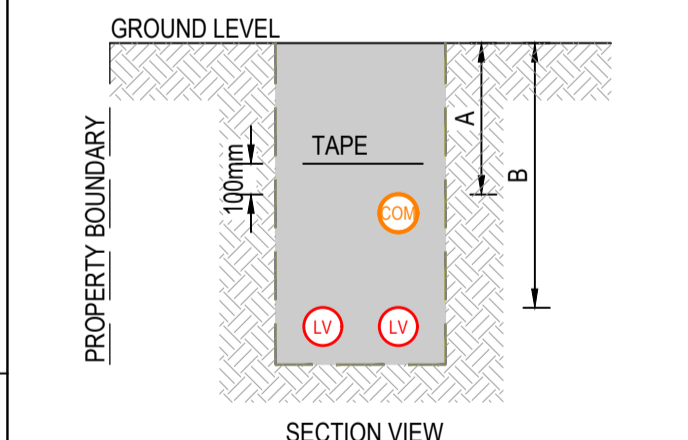

MINIMUM CONDUIT DEPTH *		
LOCATION	A	B
Verge	450mm	750mm
Local Road	600mm	Energex 800mm; Ergon 900mm
DTMR Road	800mm	1200mm

* supercedes Energex/Ergon requirements

AS CONSTRUCTED

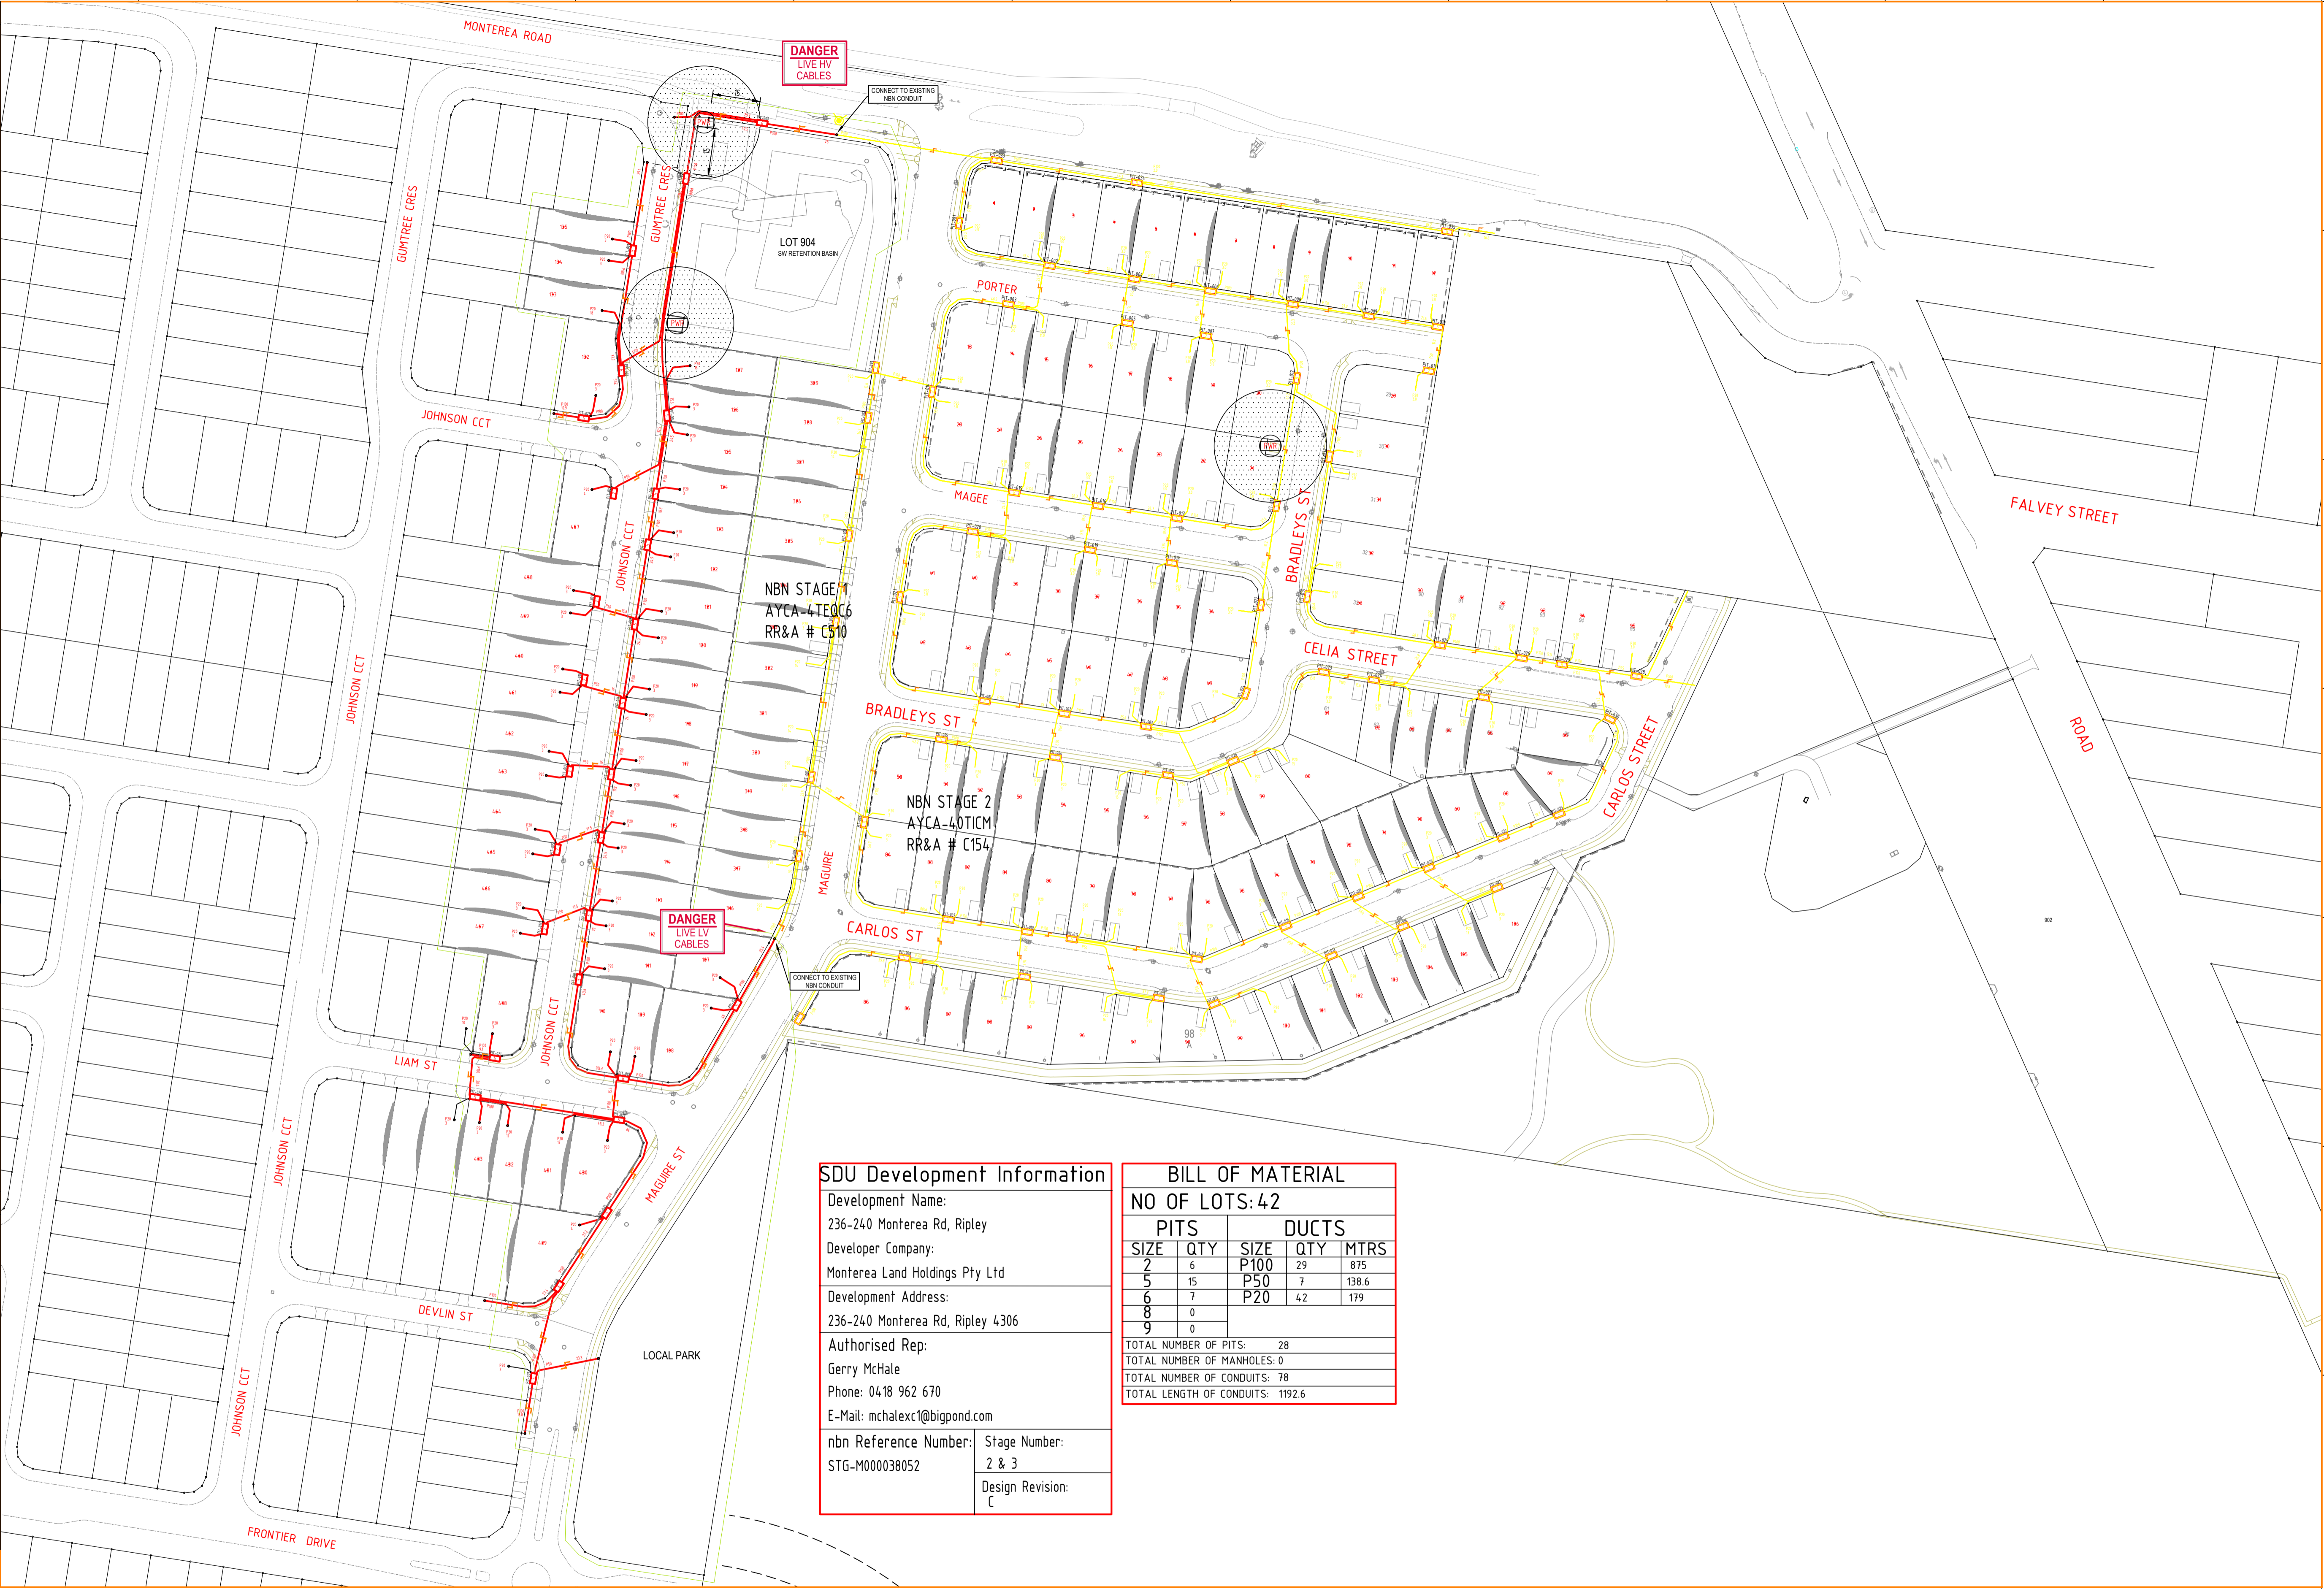

SDU Development Information

Development Name:
236-240 Monterey Rd, Ripley

Developer Company:
Monterea Land Holdings Pty Ltd

Development Address:
236-240 Monterey Rd, Ripley 4306

Authorised Rep:
Gerry McHale
Phone: 0418 962 670
E-Mail: mchalex1@bigpond.com

nbn Reference Number: STG-M000038052

Stage Number:
2 & 3

Design Revision:
C

BILL OF MATERIAL

NO OF LOTS: 42

PITS		DUCTS		
SIZE	QTY	SIZE	QTY	MTRS
2	6	P100	29	875
5	15	P50	7	138.6
6	7	P20	4.2	179
8	0			
9	0			

TOTAL NUMBER OF PITS: 28
 TOTAL NUMBER OF MANHOLES: 0
 TOTAL NUMBER OF CONDUITS: 78
 TOTAL LENGTH OF CONDUITS: 1192.6



REV	DATE	DRAFTER	DESCRIPTION	APPROVED
D	30/06/2021	S.M.	AS BUILT	K.R.
C	18/12/2020	SHANE MILLS	REVISED ZERO LOTS	K.R.
B	07/10/2020	SHANE MILLS	REVISED ROAD CROSSING LIAM ST	K.R.
A	22/06/2020	SHANE MILLS	ORIGINAL	K.R.


STRICTLY CONFIDENTIAL

NBNC APPROVAL RECORD:

SIGNATURE	DATE
<input type="checkbox"/> DD	_____
<input type="checkbox"/> WD	_____
<input type="checkbox"/> AB	_____

QUALITY RECORD:

NBNC DISCLAIMER
 THIS DOCUMENT HAS BEEN PREPARED SOLELY FOR THE USE OF NBNC LIMITED (ABN 86 136 533 741) FOR USE IN MAINTAINING NBNC FACILITIES. IT HAS NOT BEEN CREATED FOR ANY OTHER USE. IT SHOULD NOT BE SCALED TO LOCATE NBNC ASSETS. NO WARRANTY IS GIVEN THAT THE INFORMATION IS ACCURATE OR COMPLETE.

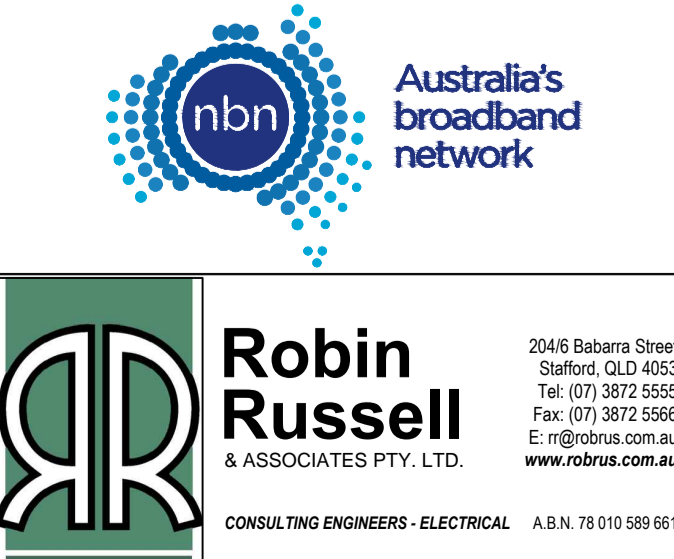

DRAWING TITLE:
236-240 Monterey Rd, Ripley Stage 2 & 3
236-240 Monterey Rd
Ripley
4306

ENABLE#: 279321

STATE: QLD REGION:

FSA: SAM: ADA:

PROJECT No: STG-M000038052

CADREF No: D337

SCALE 1:1000 SHEET No. 1 OF 1 REV. D