



**REGISTERED SURVEYOR'S CERTIFICATION**  
 I, LandPartners Pty Ltd, hereby certify that the vertical and horizontal locations and dimensions shown on this plan are a true and correct record and were located by survey.  
C. Walters  
 LandPartners Pty Ltd, Reg. Surveyor No. S4118 Date: 18/07/2023

**ENGINEER'S CERTIFICATION**  
 I, \_\_\_\_\_, hereby certify that:  
 1. The information contained in this drawing / document is in compliance with approved drawings and design.  
 2. The new water and sewerage works defined by this drawing have been designed and constructed in accordance with the SEQ Code.  
 3. This represents an accurate record of as-constructed works.  
 4. I accept responsibility for the information contained in this drawing / document.  
 RPEQ (signature) \_\_\_\_\_ RPEQ No. \_\_\_\_\_ Date: \_\_\_\_\_

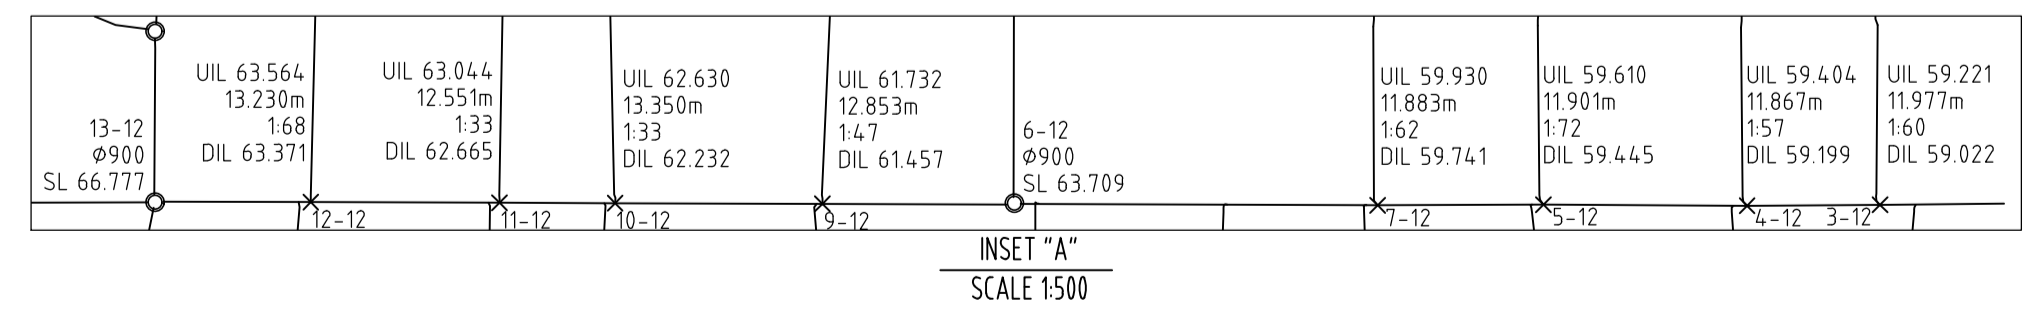

**AS CONSTRUCTED**

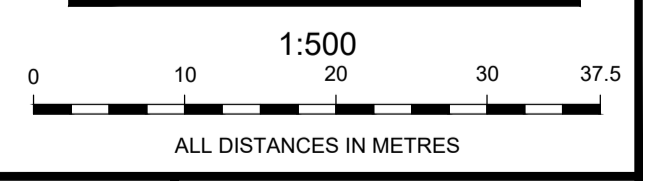

A1	2	18/07/2023	MINOR AMENDMENTS	VO	RA	CW
	1	18/07/2023	INITIAL ISSUE	VO	RA	CW
	INDEX DATE REVISIONS			DRAWN	CHECKED	PASSED
				INITIALS	DATE	

**LANDPARTNERS**  
 surveyors and planners  
 Brisbane Office  
 Level 1  
 18 Little Chubb Street  
 Milton Qld 4064  
 PO Box 1399  
 Milton Qld 4064  
 (07) 3842 1000  
 info@landpartners.com.au  
 www.landpartners.com.au

**QUEENSLAND**  
**UrbanUtilities**

**Queensland Urban Utilities**  
 236-350 MONTEREA RD PRECINCT 2 - STAGES 5B & 6  
 AS CONSTRUCTED SEWER  
 21-PNT-53396

SCALE 1:500  
 SHEET 1 OF 1 SHEETS  
 DRAWING NO.  
 BRSS6904-005-79-2