


NOTES:  
-ALL WATER RETICULATION PIPES ARE Ø180, PE-100, AND CLASS 'PN16'

LEGEND

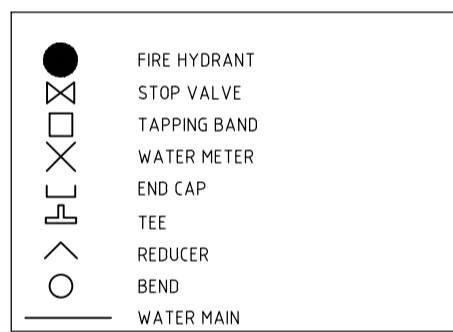

REGISTERED SURVEYOR'S CERTIFICATION

..... LandPartners Pty Ltd ..... hereby certify that the vertical and horizontal locations and dimensions shown on this plan are a true and correct record and were located by survey.


*C. Walters*  
LandPartners Pty Ltd, Reg. Surveyor No. S4118 Date: 18/07/2023

ENGINEER'S CERTIFICATION

- I, ....., hereby certify that:
- The information contained in this drawing / document is in compliance with approved drawings and design.
  - The new water and sewerage works defined by this drawing have been designed and constructed in accordance with the SEQ Code.
  - This represents an accurate record of as-constructed works.
  - I accept responsibility for the information contained in this drawing / document.

RPEQ (signature) \_\_\_\_\_ RPEQ No. \_\_\_\_\_ Date: \_\_\_\_\_

AS CONSTRUCTED

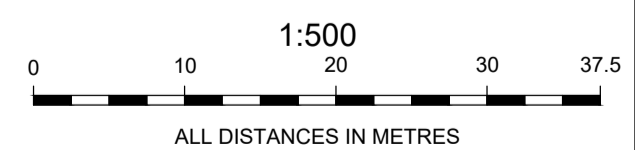

A1

INDEX	DATE	REVISIONS	DRAWN	CHECKED	PASSED
1	18/07/2023	INITIAL ISSUE	VO	RA	CW

INITIALS	DATE
VO	18/07/2023
RA	18/07/2023
CW	18/07/2023



Brisbane Office  
Level 1  
18 Little Chubb Street  
Milton Qld 4054  
PO Box 1399  
Milton Qld 4054  
Tel: (07) 3842 1000  
info@landpartners.com.au  
www.landpartners.com.au



Queensland Urban Utilities

236-350 MONTEREA RD PRECINCT 2 - STAGES 5B & 6  
AS CONSTRUCTED WATER  
21-PNT-53396

SCALE 1:500  
SHEET 1 OF 1 SHEETS  
DRAWING NO.  
BRSS6904-005-80-1