




LOT 337  
S3173

LOT 917  
SP326602


NOTES:  
-ALL SEWER RETICULATION PIPES ARE Ø160 PE SDR21 U.N.O  
-ALL SEWER HOUSE CONNECTIONS PIPES ARE Ø110 PE SDR21 U.N.O

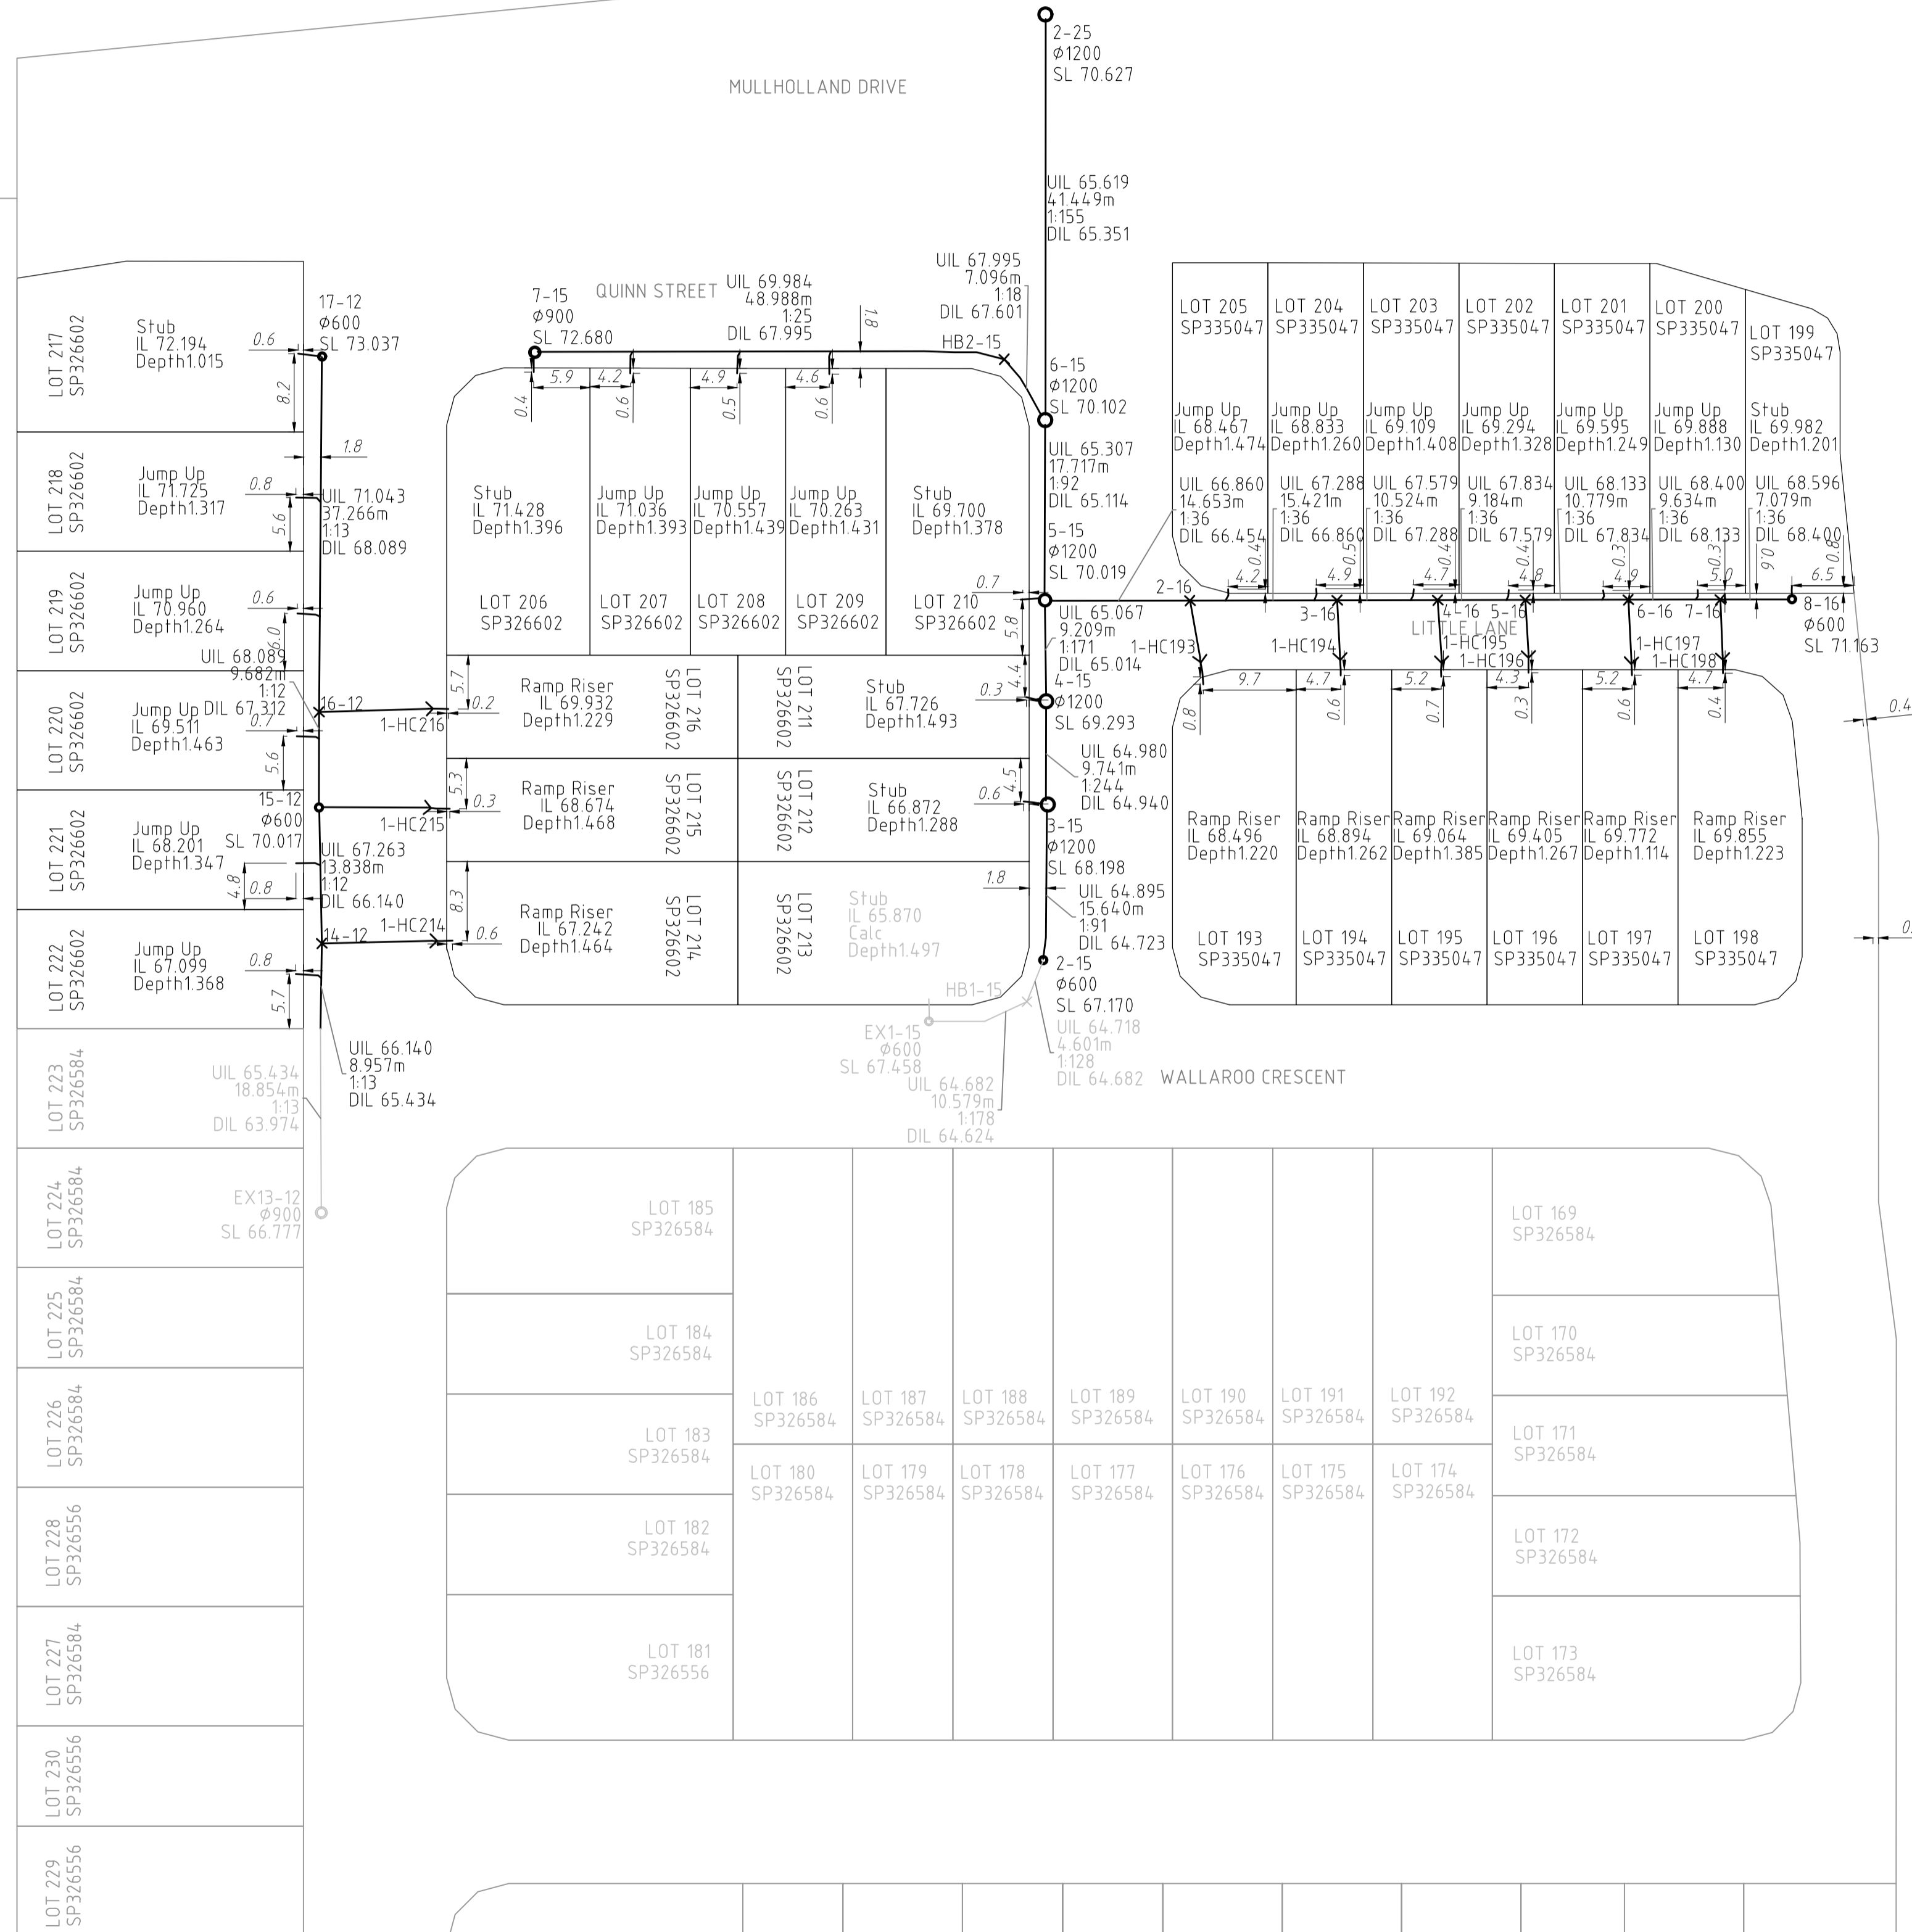

**REGISTERED SURVEYOR'S CERTIFICATION**  
 I, LandPartners Pty Ltd..... hereby certify that the vertical and horizontal locations and dimensions shown on this plan are a true and correct record and were located by survey.  
R. G. Andrew, Authorised Delegate  
 LandPartners Pty Ltd, Reg. Surveyor No. S4118 Date: 24/01/2024.

**ENGINEERS CERTIFICATION**  
 I, ..... hereby certify that:  
 1. The information contained in this drawing / document is in compliance with approved drawings and design.  
 2. The new water and sewerage works defined by this drawing have been designed and constructed in accordance with the SEQ Code.  
 3. This represents an accurate record of as-constructed works.  
 4. I accept responsibility for the information contained in this drawing / document.  
 RPEQ (signature) \_\_\_\_\_ RPEQ No. \_\_\_\_\_ Date: \_\_\_\_\_

AS CONSTRUCTED

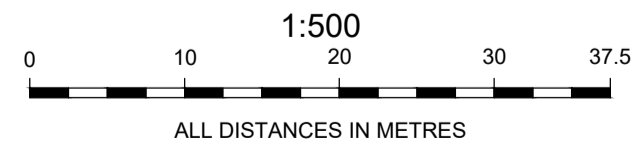

A1

INDEX	DATE	INITIALS	REVISIONS	DRAWN	CHECKED	PASSED
1	24/01/2024	MJK	INITIAL ISSUE	MJK	BJB	RA

DRAWN	CHECKED	PASSED	INITIALS	DATE
MJK	BJB	RA		24/01/2024
				24/01/2024
				24/01/2024

**Queensland Urban Utilities**  
 236-240 MONTEREA RD PRECINCT 2 - STAGES 7 & 7A  
 AS CONSTRUCTED SEWER  
 21-PNT-54-718

SCALE 1:500  
 SHEET 1 OF 1 SHEETS  
 DRAWING NO.  
 BRSS6904-007-69-1