

**AS CONSTRUCTED CERTIFICATION**

I, \_\_\_\_\_ (Company's representative Name) \_\_\_\_\_ (Signature)

(Date) \_\_\_\_\_ (IRPEQ)

Being a duly representative of- \_\_\_\_\_ (Company Name)

Hereby certify that

- The information contained in this drawing / document is in compliance with approved drawings and design supplied under the terms of the contract.
- This represents an accurate "As Constructed" record of works carried out and accept responsibility for the information contained in this drawing / document.

**NOTES**

- ALL STORMWATER PIPES ARE FRC '4' U.N.O
- ALL ROOFWATER PIPES ARE 150 PVC U.N.O


**REGISTERED CADASTRAL SURVEYOR (QLD) CERTIFICATION**

LandPartners Pty Ltd, hereby certify that the horizontal and vertical locations, and dimensions shown on this plan are a true and correct record of the As Constructed information.

Signed R. G. Anderson Date 21/08/2024  
(Authorised Delegate)

LandPartners Pty Ltd, Registered Cadastral Surveyor SBQ ID 4118

**COORDINATE DATUM NOTE:**  
HORIZONTAL COORDINATES (E,N) SUPPLIED ARE MAPPING GRID OF AUSTRALIA (MGA), ZONE 56 BASED ON THE UNIVERSAL TRANSVERSE MERCATOR PROJECTION AND THE GEOCENTRIC DATUM OF AUSTRALIA 2020.

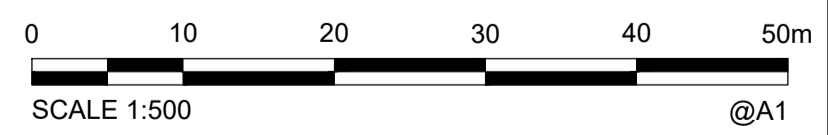

A1	1	21/08/2024	INITIAL ISSUE	MK	RA	RA
	INDEX	DATE	REVISIONS	DRAWN	CHECKED	PASSED

DRAWN	MK	21/08/2024
CHECKED	RA	21/08/2024
PASSED	RA	21/08/2024
INITIALS	DATE	

Stishare Office  
Level 1  
18 Lake Cobia Street  
Milton QLD 4064

PO Box 1399  
Milton  
QLD 4064

P: (07) 3842 1000  
F: (07) 3842 1001  
E: info@landpartners.com.au  
W: www.landpartners.com.au



**IPSWICH CITY COUNCIL**

236-240 MONTEREA ROAD PRECINCT 2 - STAGES 8 & 12  
AS CONSTRUCTED STORMWATER

SCALE 1:500  
SHEET 1 OF 1 SHEETS  
DRAWING NO.  
BRSS6904-008-42-1