

**AS CONSTRUCTED CERTIFICATION**

I, \_\_\_\_\_ (Company's representative Name) \_\_\_\_\_ (Signature)

(Date) \_\_\_\_\_ (IRPEQ)

Being a duly representative of- \_\_\_\_\_ (Company Name)

Hereby certify that

- The information contained in this drawing / document is in compliance with approved drawings and design supplied under the terms of the contract.
- This represents an accurate "As Constructed" record of works carried out and accept responsibility for the information contained in this drawing / document.

**NOTES**

-ALL CONTOURS ARE SHOWN AT AN INTERVAL OF 0.5m

**LEGEND**

- BOTTOM OF WALL
- TOP OF WALL
- LIP OF KERB
- BACK OF KERB
- EDGE OF CONCRETE
- CONTOURS
- CHANGE OF GRADE
- CROWN OF ROAD
- SURFACE DRAIN


**REGISTERED CADASTRAL SURVEYOR (QLD) CERTIFICATION**

LandPartners Pty Ltd, hereby certify that the horizontal and vertical locations, and dimensions shown on this plan are a true and correct record of the As Constructed information.

Signed *R. G. Andrew* Date 21/08/2024  
(Authorised Delegate)

LandPartners Pty Ltd, Registered Cadastral Surveyor SBQ ID 4118

**COORDINATE DATUM NOTE:**  
HORIZONTAL COORDINATES (E,N) SUPPLIED ARE MAPPING GRID OF AUSTRALIA (MGA), ZONE 56 BASED ON THE UNIVERSAL TRANSVERSE MERCATOR PROJECTION AND THE GEOCENTRIC DATUM OF AUSTRALIA 2020.

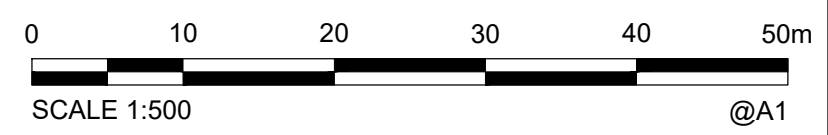

**AS CONSTRUCTED**

|           |       |            |               |       |         |        |
|-----------|-------|------------|---------------|-------|---------|--------|
| <b>A1</b> | 1     | 21/08/2024 | INITIAL ISSUE | MJK   | RA      | RA     |
|           | INDEX | DATE       | REVISIONS     | DRAWN | CHECKED | PASSED |

|          |      |            |
|----------|------|------------|
| DRAWN    | MJK  | 21/08/2024 |
| CHECKED  | RA   | 21/08/2024 |
| PASSED   | RA   | 21/08/2024 |
| INITIALS | DATE |            |

Stishare Office  
Level 1  
18 Little Cobby Street  
Milton QLD 4064

PO Box 1399  
Milton  
QLD 4064

P: (07) 3842 1000  
F: (07) 3842 1001  
E: info@landpartners.com.au  
W: www.landpartners.com.au



**IPSWICH CITY COUNCIL**

236-240 MONTEREA ROAD PRECINCT 2 - STAGES 8 & 12  
AS CONSTRUCTED TOPOGRAPHY

SCALE 1:500  
SHEET 1 OF 1 SHEETS  
DRAWING NO.  
BRSS6904-008-43-1