


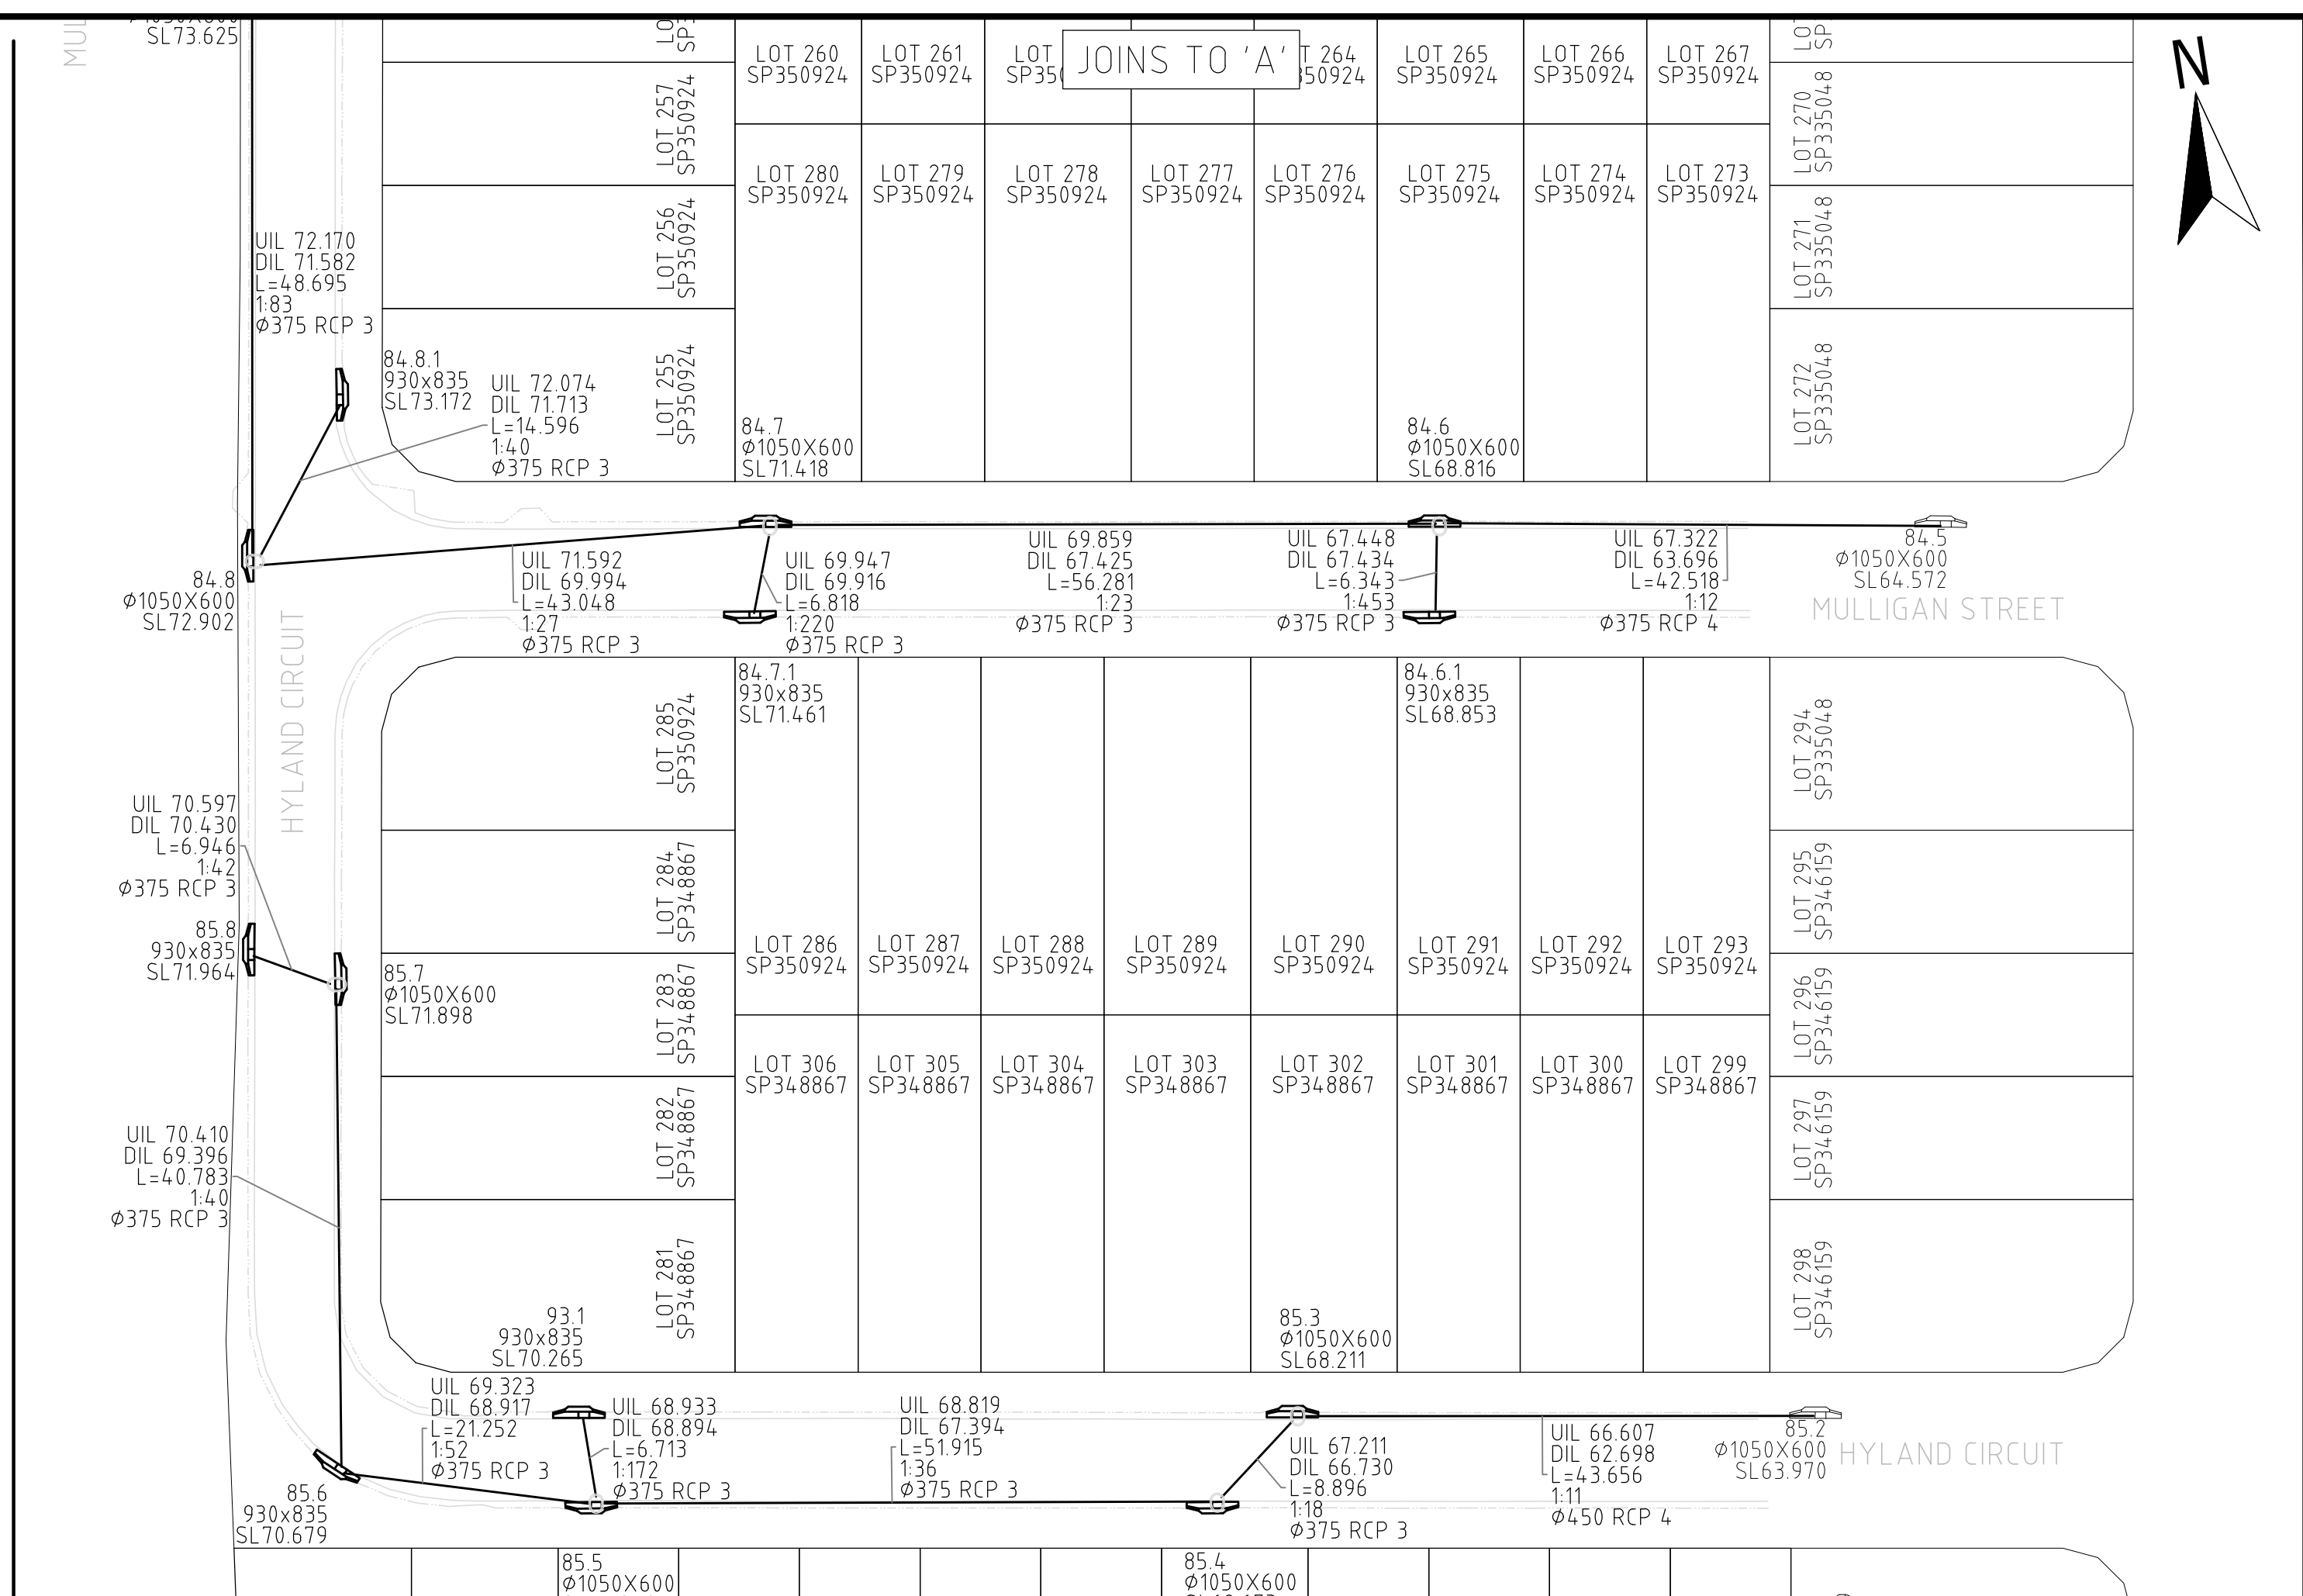

<u>AS CONSTRUCTED CERTIFICATION</u>	
I, _____ (Company's representative Name) _____ (Date) Being a duly representative of - _____ _____ (Company Name)	_____ (Signature) _____ (RPEQ)
Hereby certify that: 1. The information contained in this drawing / document is in compliance with approved drawings and design supplied under the terms of the contract. 2. This represents an accurate "As constructed" record of works carried out and accept responsibility for the information contained in this drawing / document.	

<u>REGISTERED CADASTRAL SURVEYOR (QLD) CERTIFICATION</u>		
_____ LandPartners Pty Ltd _____ hereby certify that the vertical and horizontal locations and dimensions shown on this plan are a true and correct record and were located by survey. <i>R. G. Andrew</i> Authorised Delegate LandPartners Pty Ltd Registered Qld Surveyor Corporation _____ 4/18 _____ Rego No. _____ 12/09/2025 _____ Date		

AS CONSTRUCTED

0 10 20 30 40 50m

SCALE 1:500 @A1

[illegible]