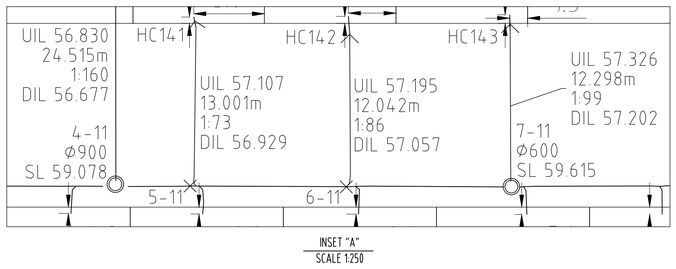

INSET "A"
SCALE 1:250

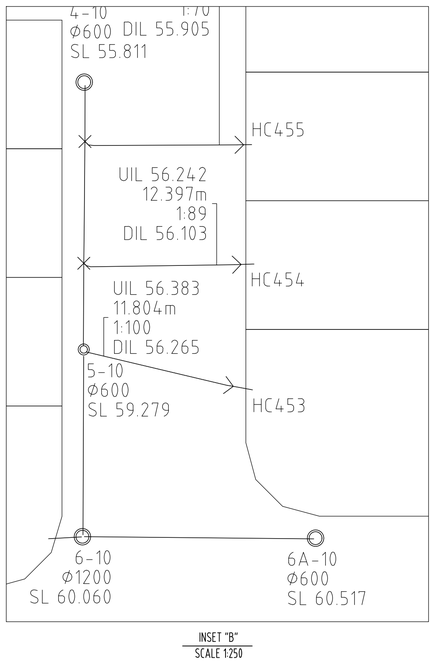

INSET "B"
SCALE 1:250

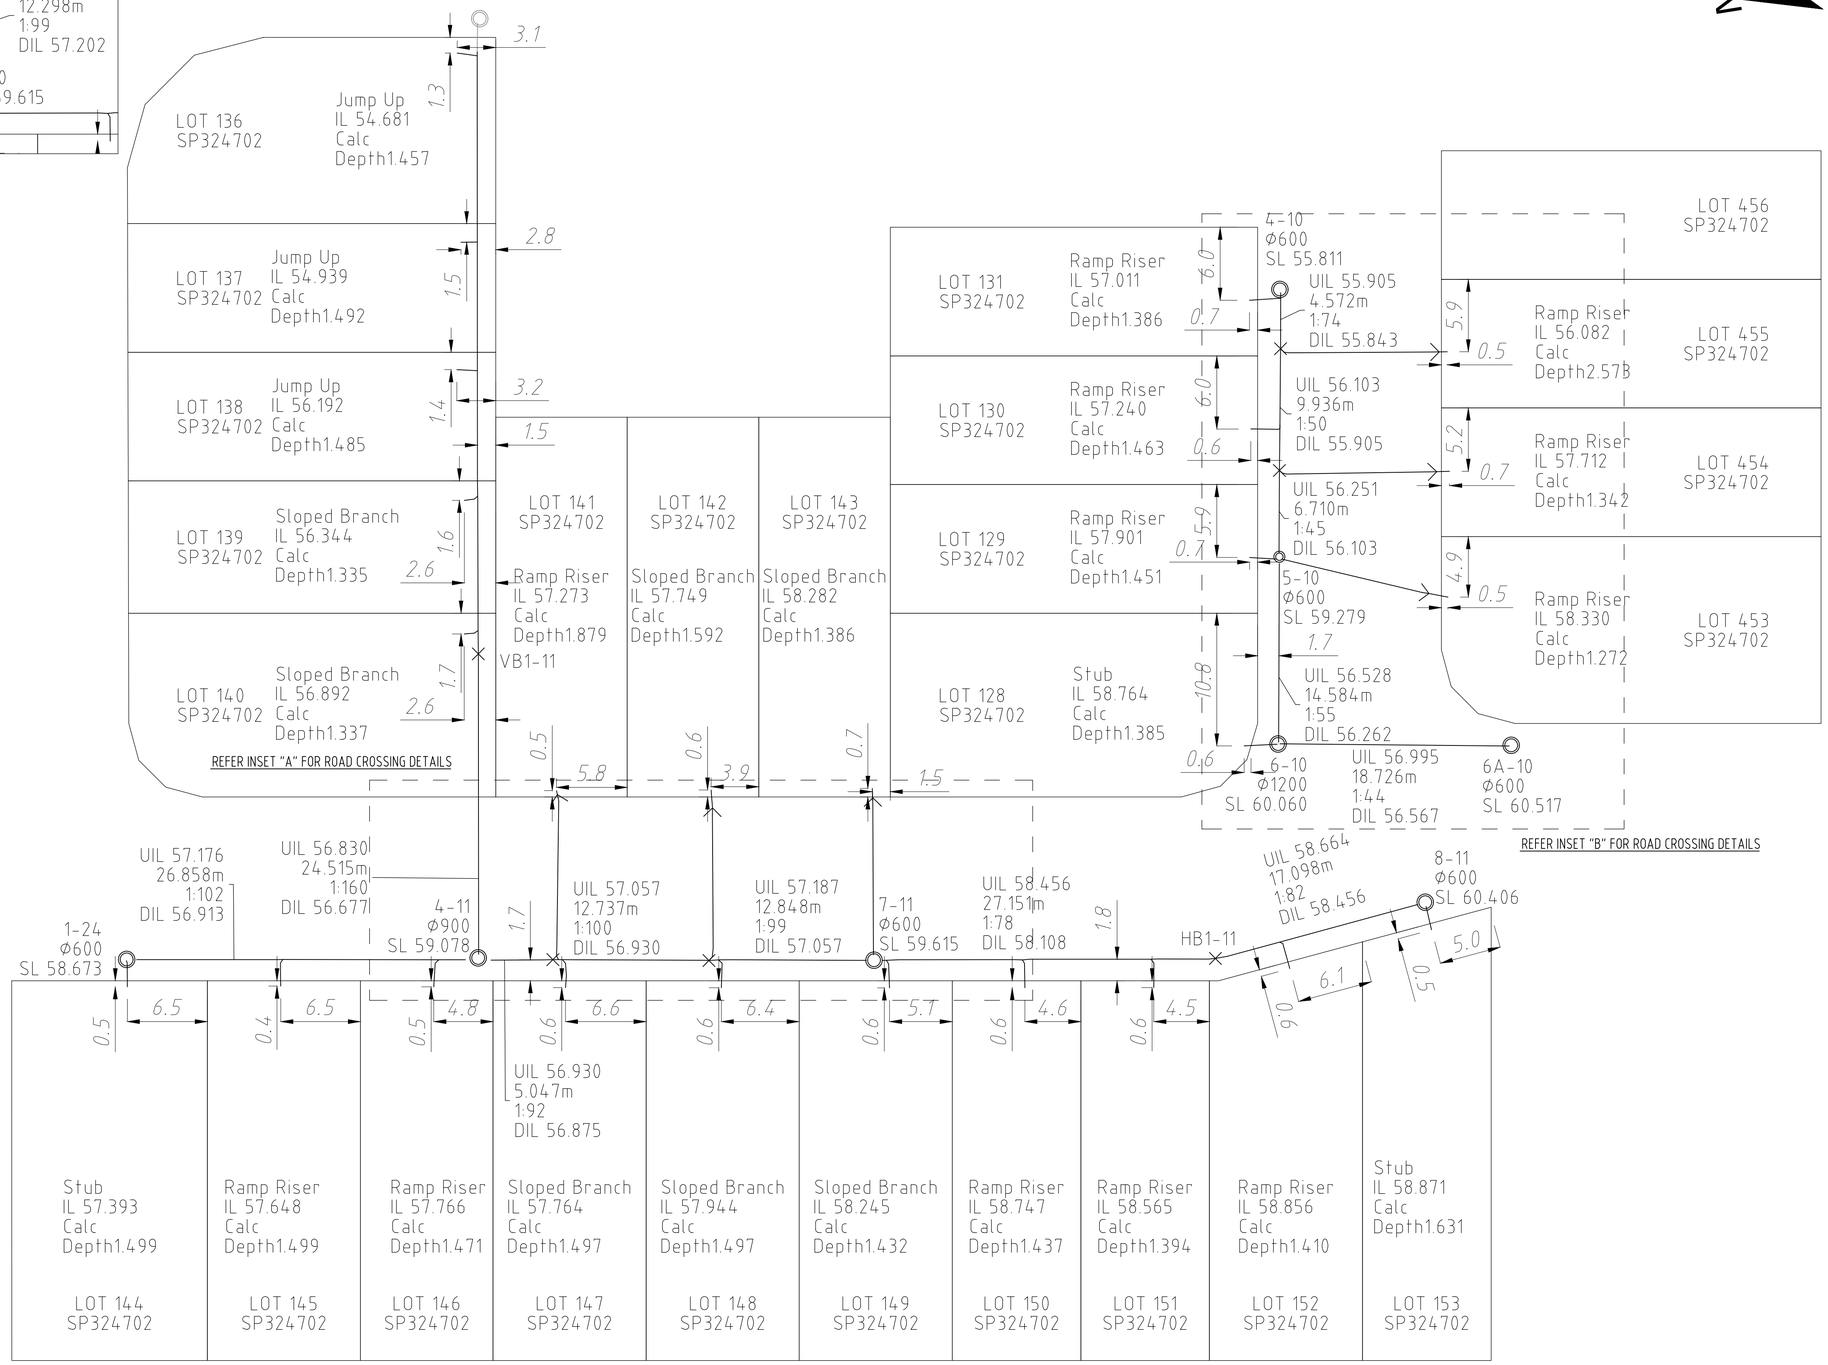

REGISTERED SURVEYOR'S CERTIFICATION

LandPartners Pty Ltd, hereby certify that the vertical and horizontal locations and dimensions shown on this plan are a true and correct record and were located by survey.

C. Walters (Authorised Delegate)
LandPartners Pty Ltd, Reg. Surveyor No. S4118 Date: 01/07/2022

ENGINEER'S CERTIFICATION

I, ..., hereby certify that:

1. The information contained in this drawing / document is in compliance with approved drawings and design.
2. The new water and sewerage works defined by this drawing have been designed and constructed in accordance with the SEQ Code.
3. This represents an accurate record of as-constructed works.
4. I accept responsibility for the information contained in this drawing / document.

RPEQ (signature) RPEQ No. _____ Date: .....

AS CONSTRUCTED

SCALE 1:250
0 5 10 15 20 25m
ALL DISTANCES IN METRES @A1

A1

INDEX	DATE	REVISIONS	DRAWN	CHECKED	PASSED
1	01/07/2022	INITIAL ISSUE	V0	RA	RA

	INITIALS	DATE
DRAWN	V0	01/07/2022
CHECKED	RA	01/07/2022
PASSED	RA	01/07/2022

LANDPARTNERS built environment consultants

QUEENSLAND UrbanUtilities

Queensland Urban Utilities

236-240 MONTEREA RD PRECINCT 2 - STAGE 4
AS-CONSTRUCTED SEWER

SCALE 1:250
SHEET 1 OF 1 SHEETS
DRAWING NO.
BRSS6904-004-63-1