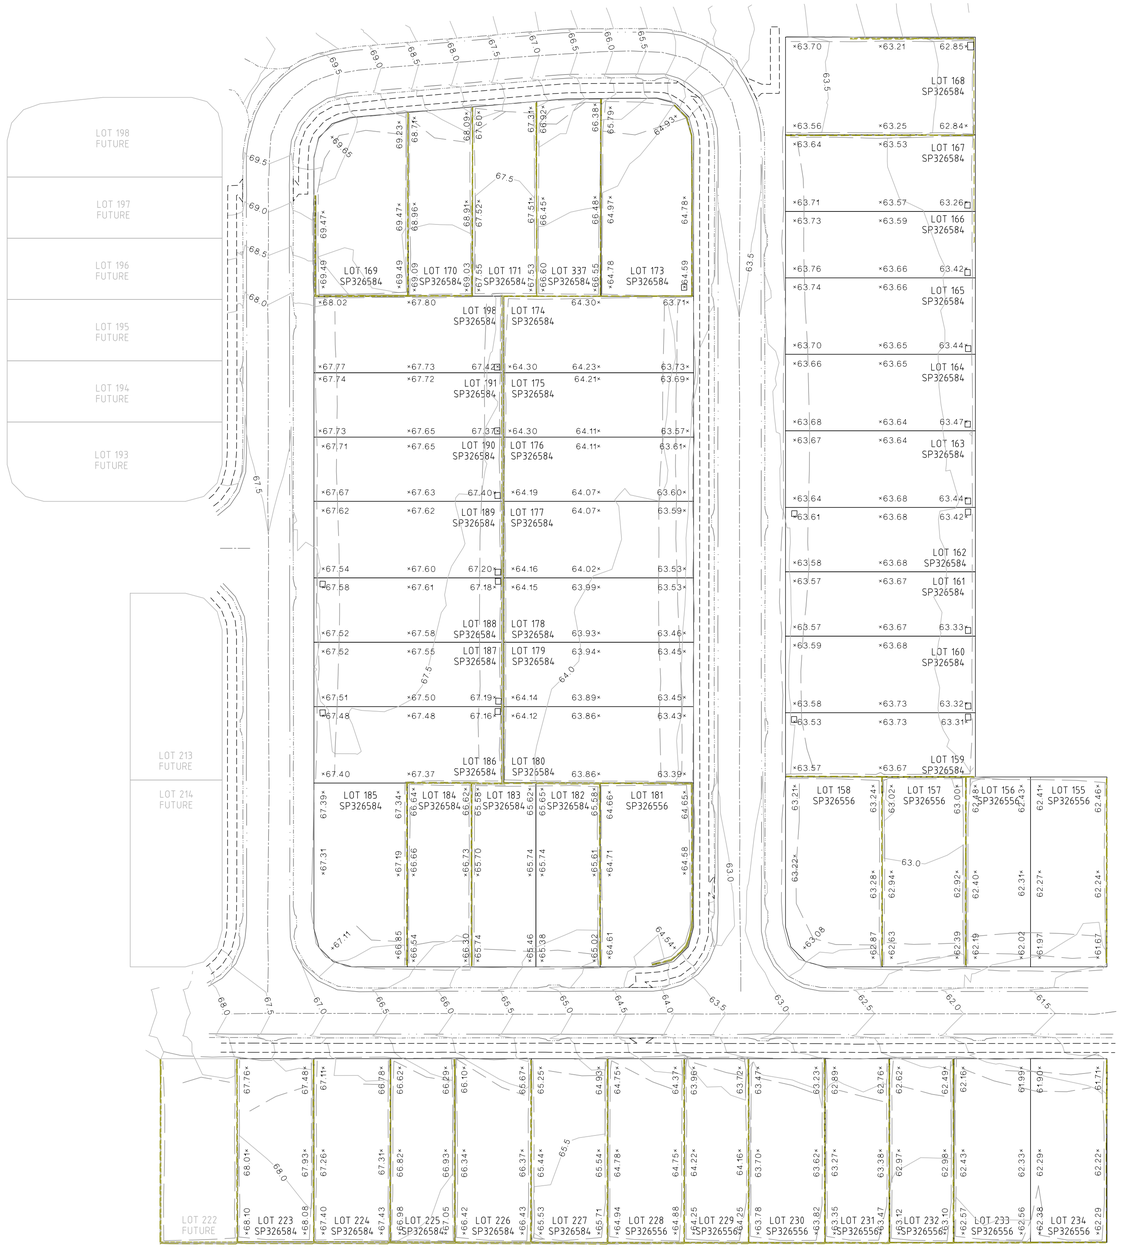

N

REGISTERED SURVEYOR'S CERTIFICATION

I, LandPartners Pty Ltd, hereby certify that the vertical and horizontal locations and dimensions shown on this plan are a true and correct record and were located by survey.

C. Walters

Registered Surveyor (sig.) Reg. Surveyor No. S4118 Date: 15/08/2023

AS CONSTRUCTED CERTIFICATION

I, ...

(Company's representative Name) (Signature)

....

(Date) (RPEQ)

Being a duly representative of:-

..... (Company Name)

Hereby certify that

1. The information contained in this drawing / document is in compliance with approved drawings and design supplied under the terms of the contract.
2. This represents an accurate "As constructed" record of works carried out and accept responsibility for the information contained in this drawing / document.

LEGEND

- BOTTOM OF WALL
- TOP OF WALL
- LIP OF KERB
- BACK OF KERB
- EDGE OF CONCRETE
- CONTOURS
- CHANGE OF GRADE
- CROWN OF ROAD

AS CONSTRUCTED

0 10 20 30 40 50m

SCALE 1:500 @A1

COORDINATE DATUM NOTE:

HORIZONTAL COORDINATES (E,N) SUPPLIED ARE MAPPING GRID OF AUSTRALIA (MGA), ZONE 56 BASED ON THE UNIVERSAL TRANSVERSE MERCATOR PROJECTION AND THE GEOCENTRIC DATUM OF AUSTRALIA 2020.

A1

INDEX	DATE	REVISIONS	DRAWN	CHECKED	PASSED
1	15/08/2023	INITIAL ISSUE	MJK	VO	CGW

	INITIALS	DATE
DRAWN	MJK	15/08/2023
CHECKED	VO	15/08/2023
PASSED	CGW	15/08/2023

LANDPARTNERS surveyors and planners
Brisbane Office
Level 1
18 Little Cribb Street
Milton Qld 4064
PO Box 1399
Milton Qld 4064
p: (07) 3842 1000
e: info@landpartners.com.au
w: www.landpartners.com.au

City of Ipswich

IPSWICH CITY COUNCIL

236-350 MONTEREA RD PRECINCT 2 - STAGES 5B & 6
AS CONSTRUCTED TOPOGRAPHY
6536/MAPDA/C

SCALE 1:500
SHEET 1 OF 1 SHEETS
DRAWING NO.
BRSS6904-005-85-1